


FILED  
GREENVILLE CO. S. C.  
NOV 7 4 34 PM '79

DONNIE S. TANKERSLEY  
R.M. BLACK WELDER

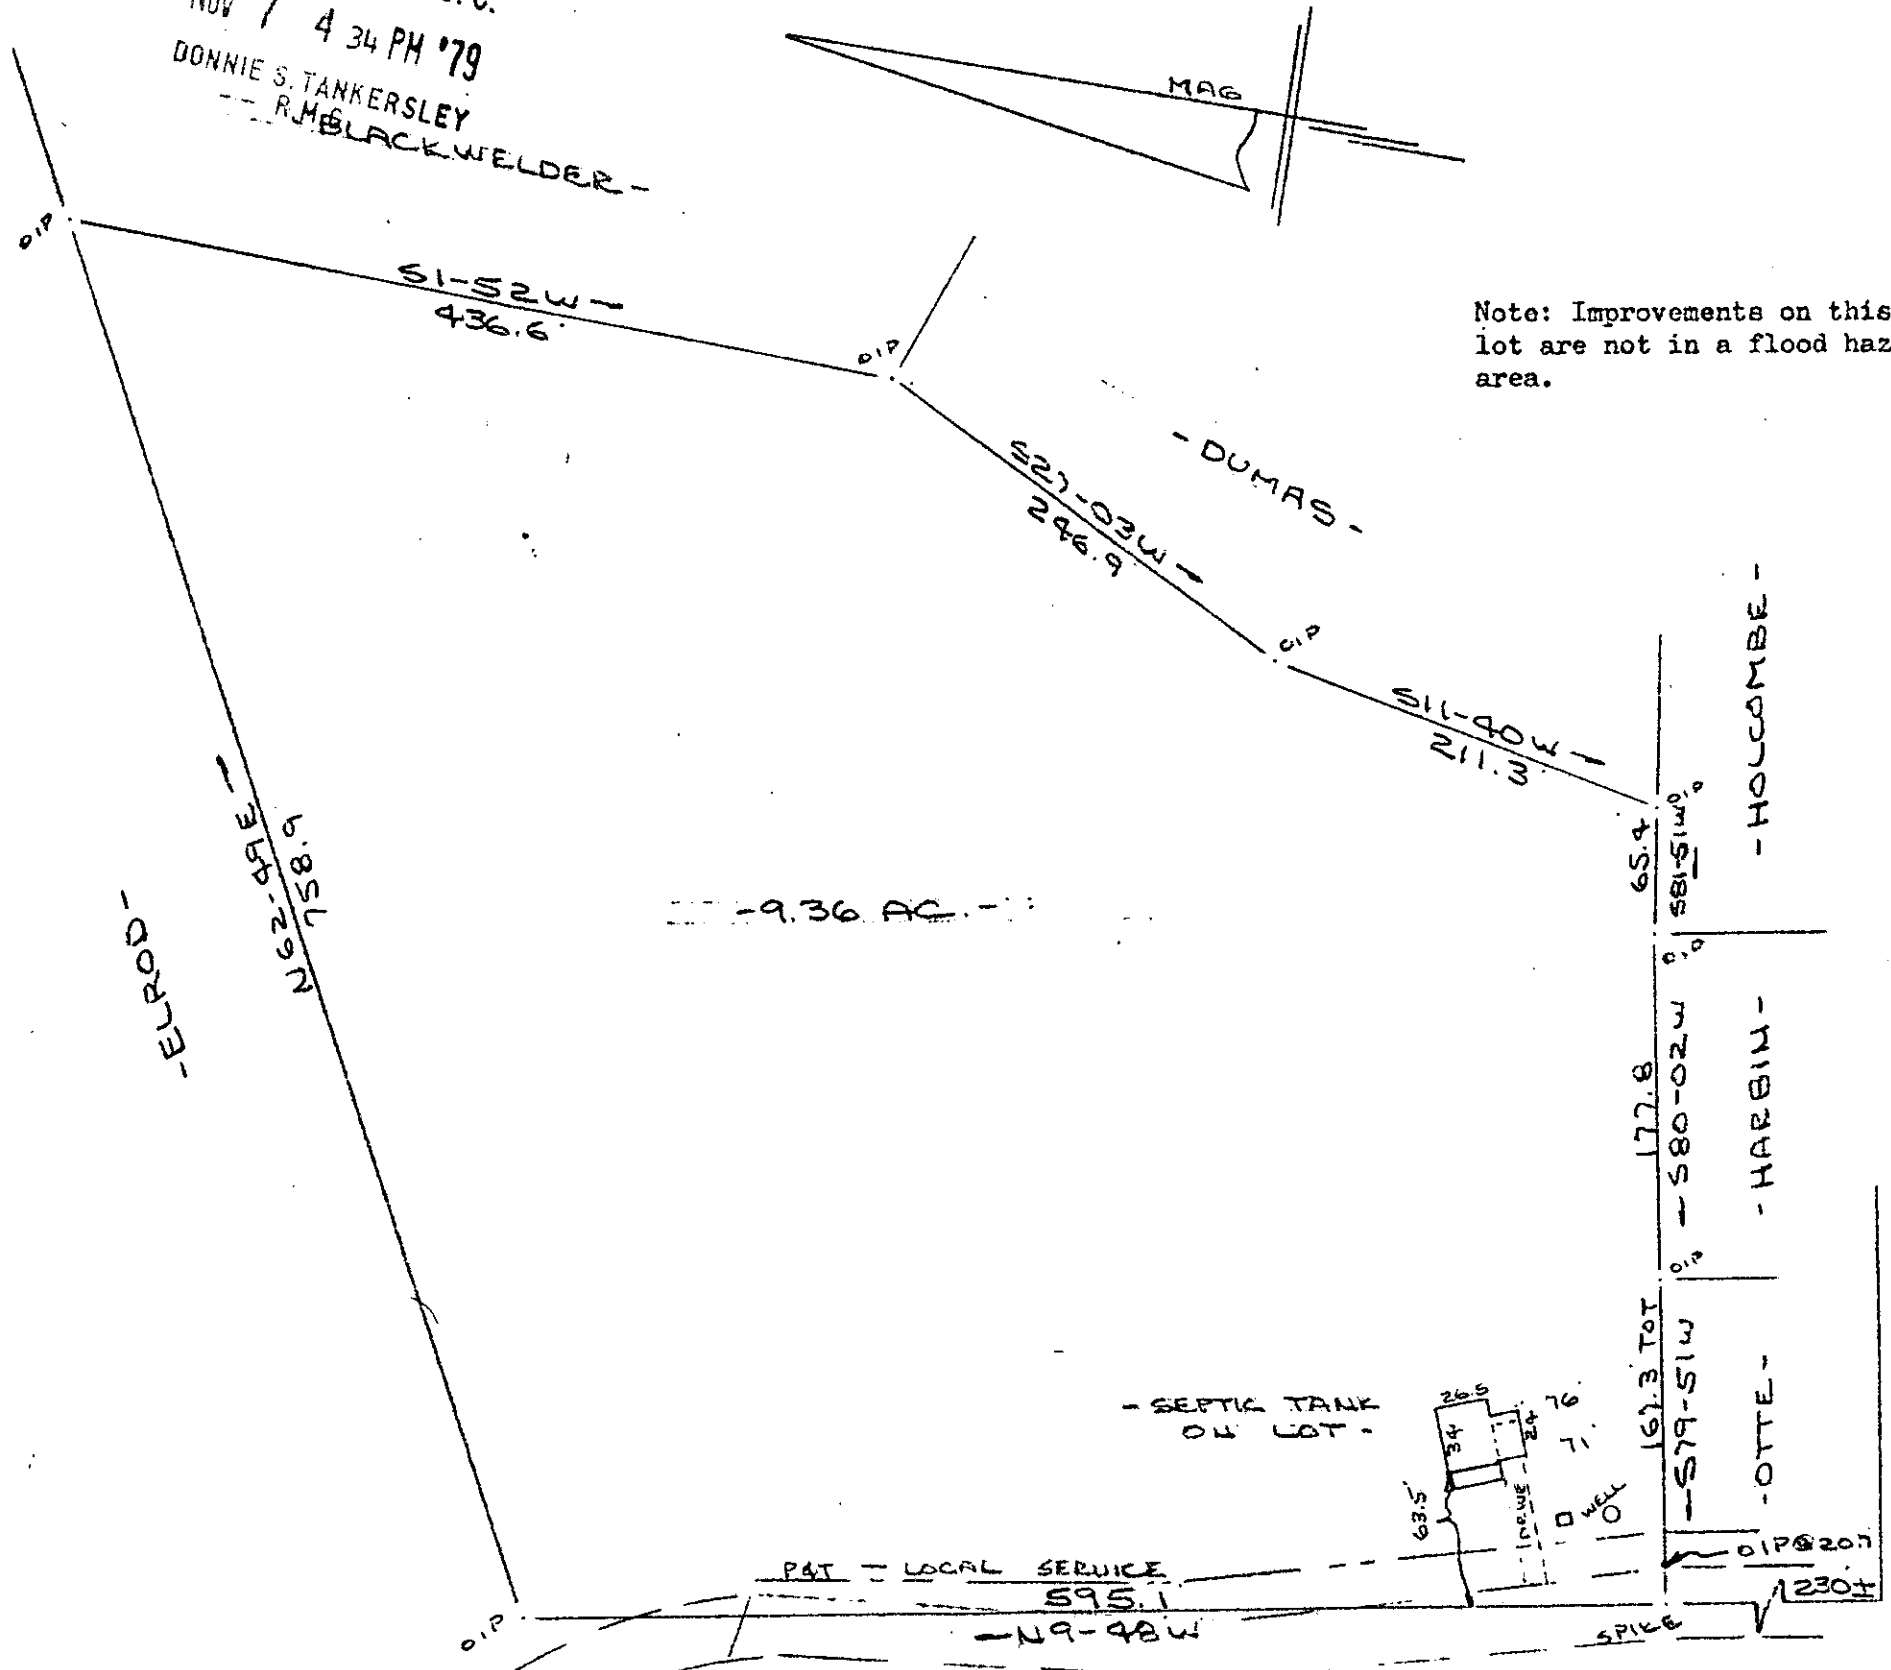

FREEMAN ROAD  
(FREEMAN LAKE ROAD)  
PROPERTY OF  
ROBERT ERIC CALDWELL  
NEAR GREENVILLE, S.C.  
SCALE: 1"=100' 5 NOV 1979

15707  
7-Q-38

This is to certify that on the 5th day of November, 1979, I surveyed the property shown on this plat, being known as PROPERTY OF MOZELLE B. TABOR and recorded in the RMC Office Greenville County, S. C., in Plat Book " 5 - F " at Page 58; and that the property lines, walls and buildings are as shown hereon, and that the walls and buildings located on said property do not encroach or project on said premises, and no power lines cross this property except as shown hereon.

CAROLINA SURVEYING CO.  
112 Manly St.  
Greenville, S. C.

R. B. Bruce  
R. B. Bruce, RLS #1952