


FILED
GREENVILLE CO. S. C.
Nov 16 4 33 PM '79
DONNIE S. TANKERSLEY
R.M.C.



40-1-3

40-1-6

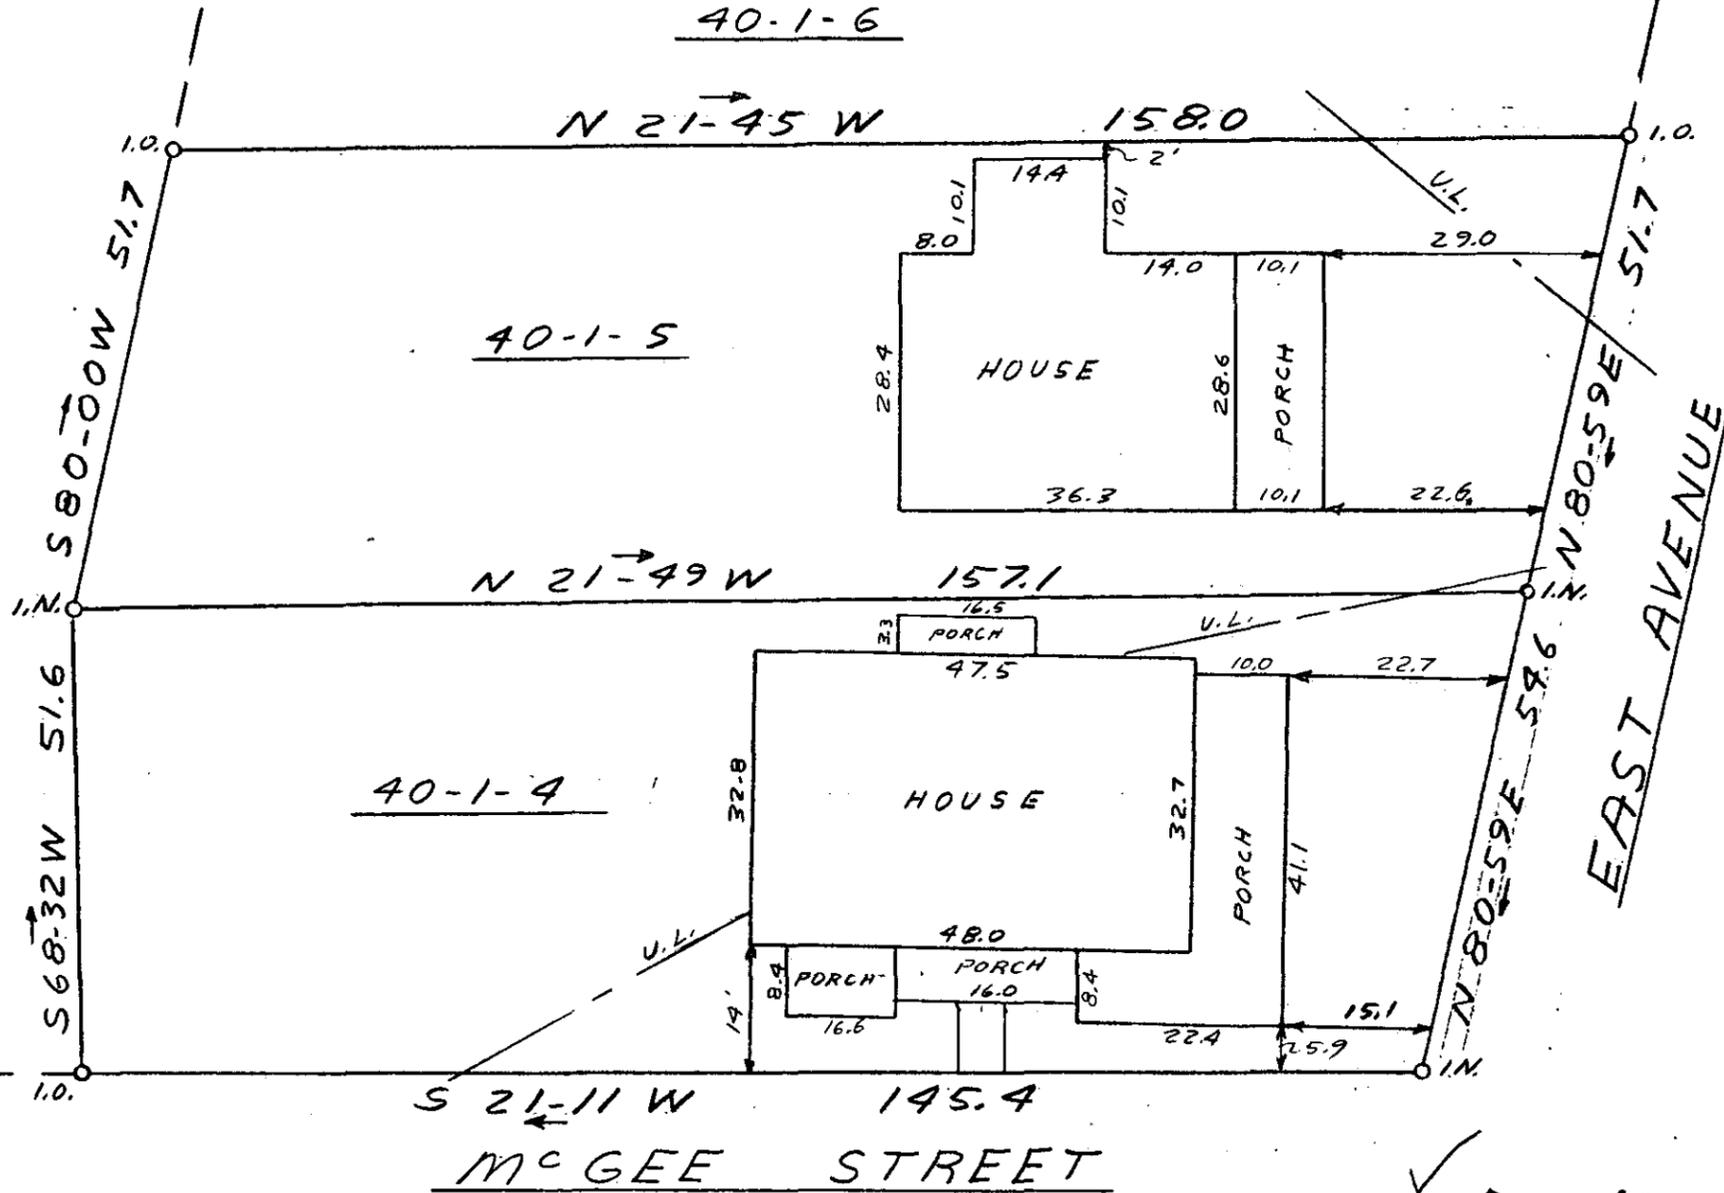

EAST AVENUE

McGEE STREET

7Q-49

16828

This is to certify that on November 16, 1979, I surveyed the property shown on this plat, known as Property of Peter J. Sasso, Jr. & M. Leonard Ledford, recorded in the RMC Office of Greenville County in Deed Book 1095 on page 477, and that the property lines, walls and buildings are as shown hereon; that the buildings located on said lot do not encroach or project on adjacent streets or property, and that no adjacent walls or buildings encroach or project on said premises, and that no utility lines cross this property except as shown hereon. This property is not located in a designated flood hazard area.

James R. Freeland
James R. Freeland RLS & PE 4781



STATE OF SOUTH CAROLINA
GREENVILLE COUNTY

PROPERTY OF
S. & L. INVESTMENTS

FREELAND & ASSOCIATES
Engineers - Land Surveyors
GREENVILLE, S.C.

SURVEY JRF
DRAWN JRF
CHECK S.R.
SCALE 1" = 20'
DATE 11-16-79
DWG. NO. 79-4426

MICROFILMED

GCTO -- 1 N01679 1167 5.00CI