


FILED
GREENVILLE CO. S. C.
NOV 27 1 13 PM '79
DONNIE S. TANKERSLEY
R.M.C.
238

2.81 ACRES

NOV 27 1979

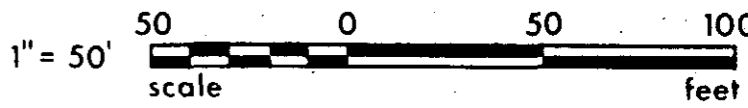

7-9-58 17685

This is to certify that on November 26, 1979, I surveyed the property shown on this plat, known as Lots 292, 293, 231, 232, 233, 234, and Pt. lot 230 on plat of Traxler Park, recorded in the RMC Office of Greenville County in Plat Book F on page 114 and 115, and that the property lines, walls and buildings are as shown hereon; that the building located on said lots does not encroach or project on adjacent streets or property, and that no adjacent walls or buildings encroach or project on said premises, and that no utility lines cross this property except as shown hereon. This property is not located in a designated flood hazard area.

James R. Freeland
James R. Freeland RLS & PE 4781



STATE OF SOUTH CAROLINA
GREENVILLE COUNTY
TRAXLER PARK
LOTS 292, 293, 231, 232,
233, & PART LOT 230
PROPERTY OF
DOUGLAS N. KELLY

FREELAND & ASSOCIATES Engineers • Land Surveyors GREENVILLE, S.C.
SURVEY LT
DRAWN JRF
CHECK FEL
SCALE 1" = 50'
DATE 11-26-79
DWG. NO. 79-4463

MICROFILMED