


U.S.C.
DEC 5 3 52 PM '79
DONNIE S. TANKERSLEY
R.M.C.

MAP NO. 7 SUGAR CREEK

MAP NO. 4 SUGAR CREEK

MICROFILM

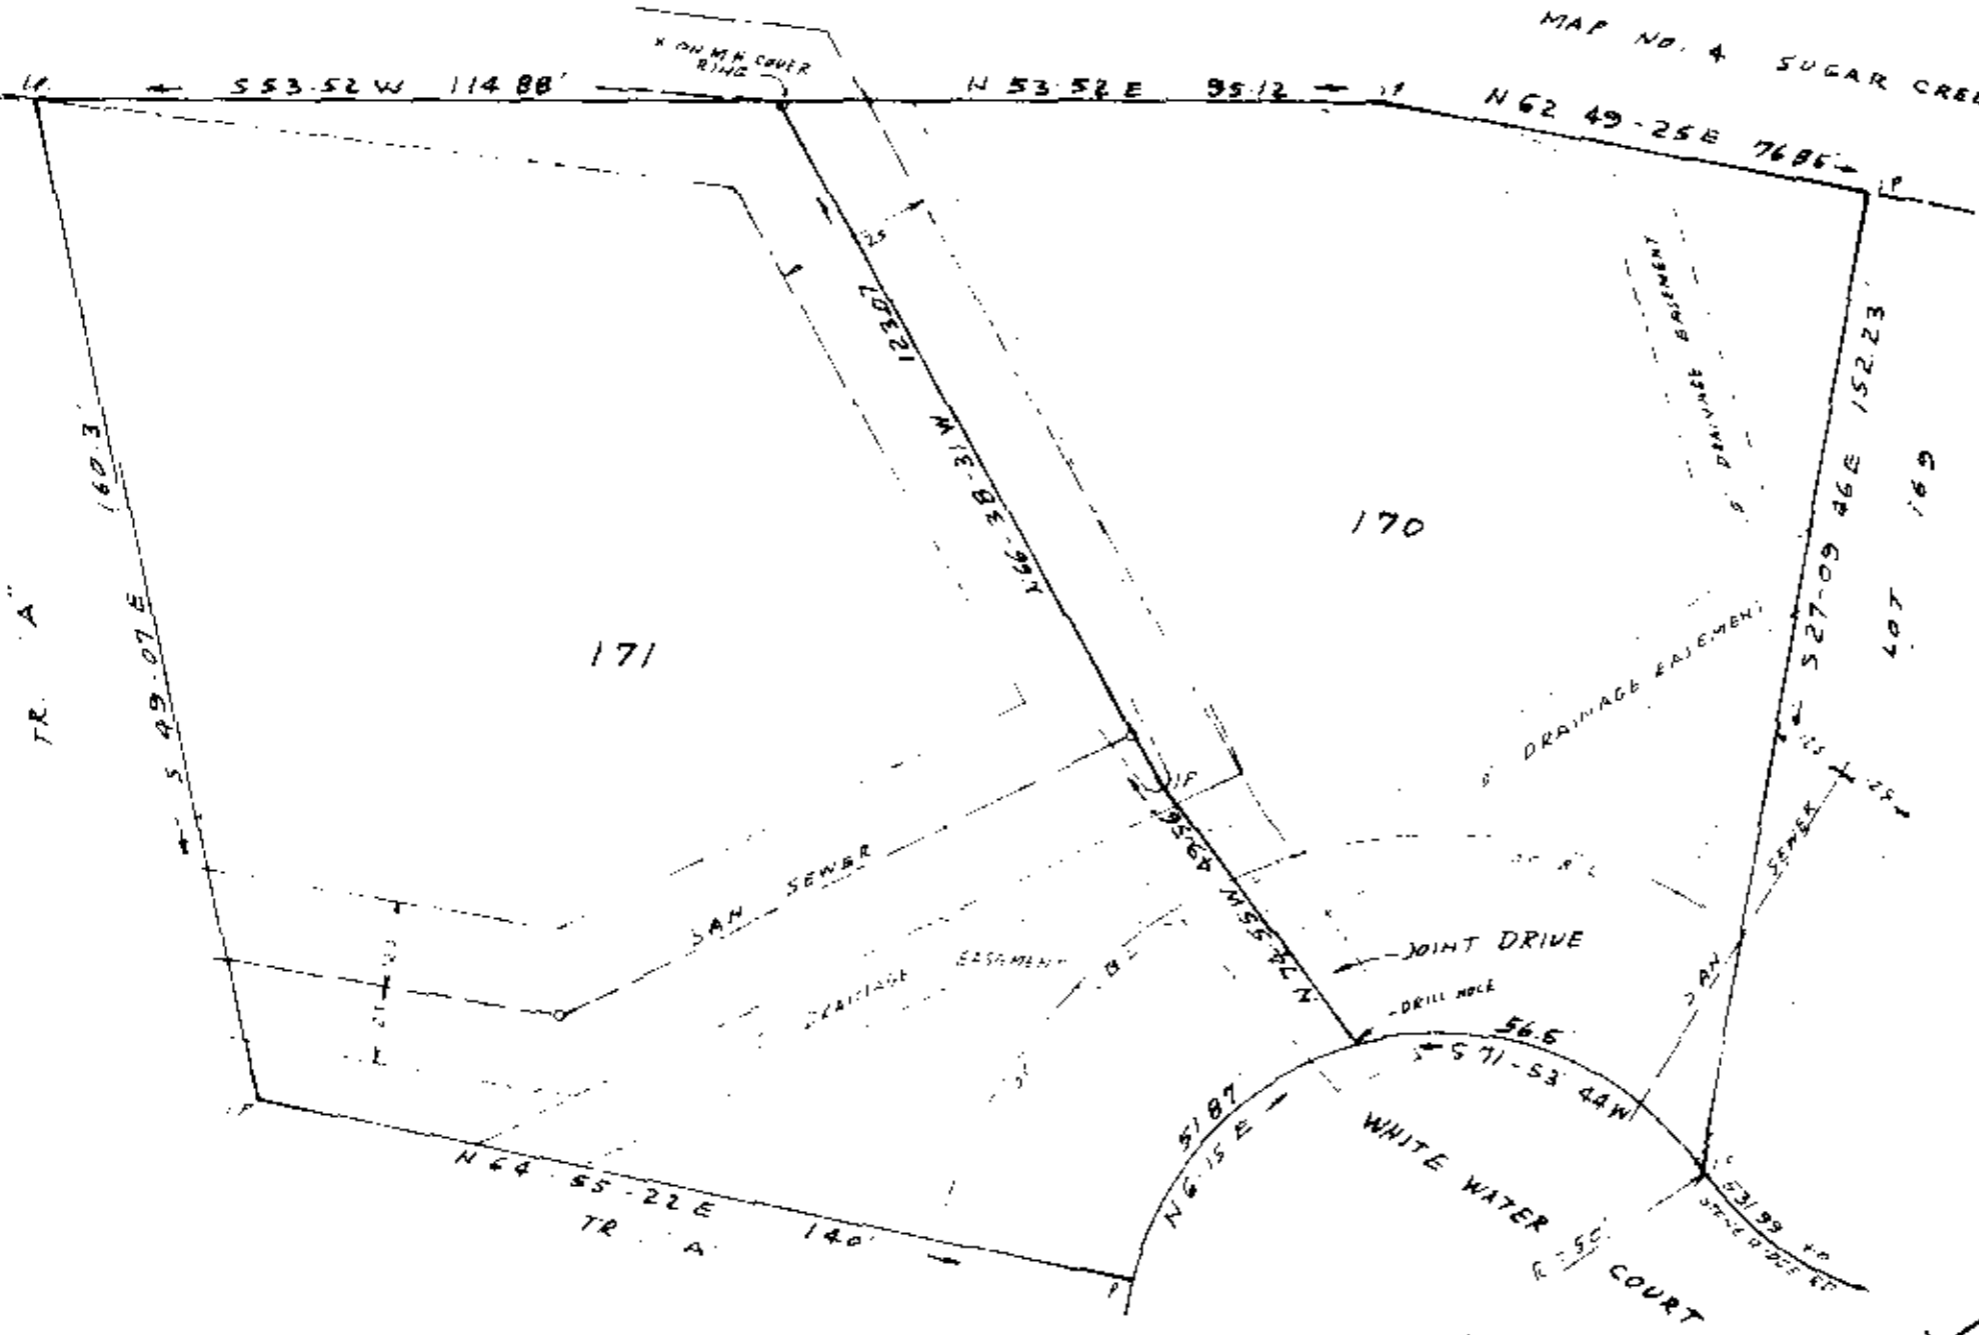

DEC 5 1979

7-Q-73

REF: PLAT OF MAP NO. 2 SUGAR CREEK
RECORDED IN PLAT BOOK 4R PAGE 85.

NOTE: DRAINAGE AND UTILITIES EASEMENT
5' EACH SIDE OF SIDE AND REAR LOT LINES

REVISION - LOTS 170 & 171 MAP NO. 2 18705 '05
SUGAR CREEK
 NEAR GREENVILLE S.C.
 SCALE 1" = 30' DEC. 4, 1979

C.D. Riddle, RLS 1397 - Greenville S.C.