



NOTES:

MICROFILMED

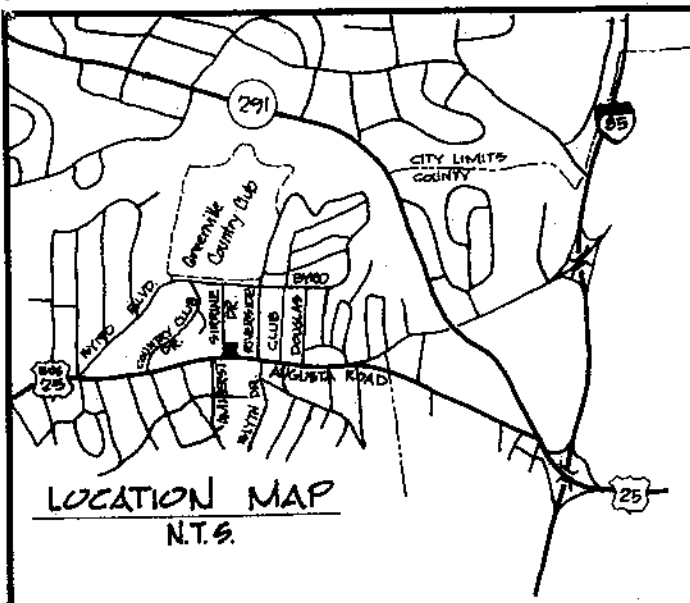

SIRRIANE DRIVE

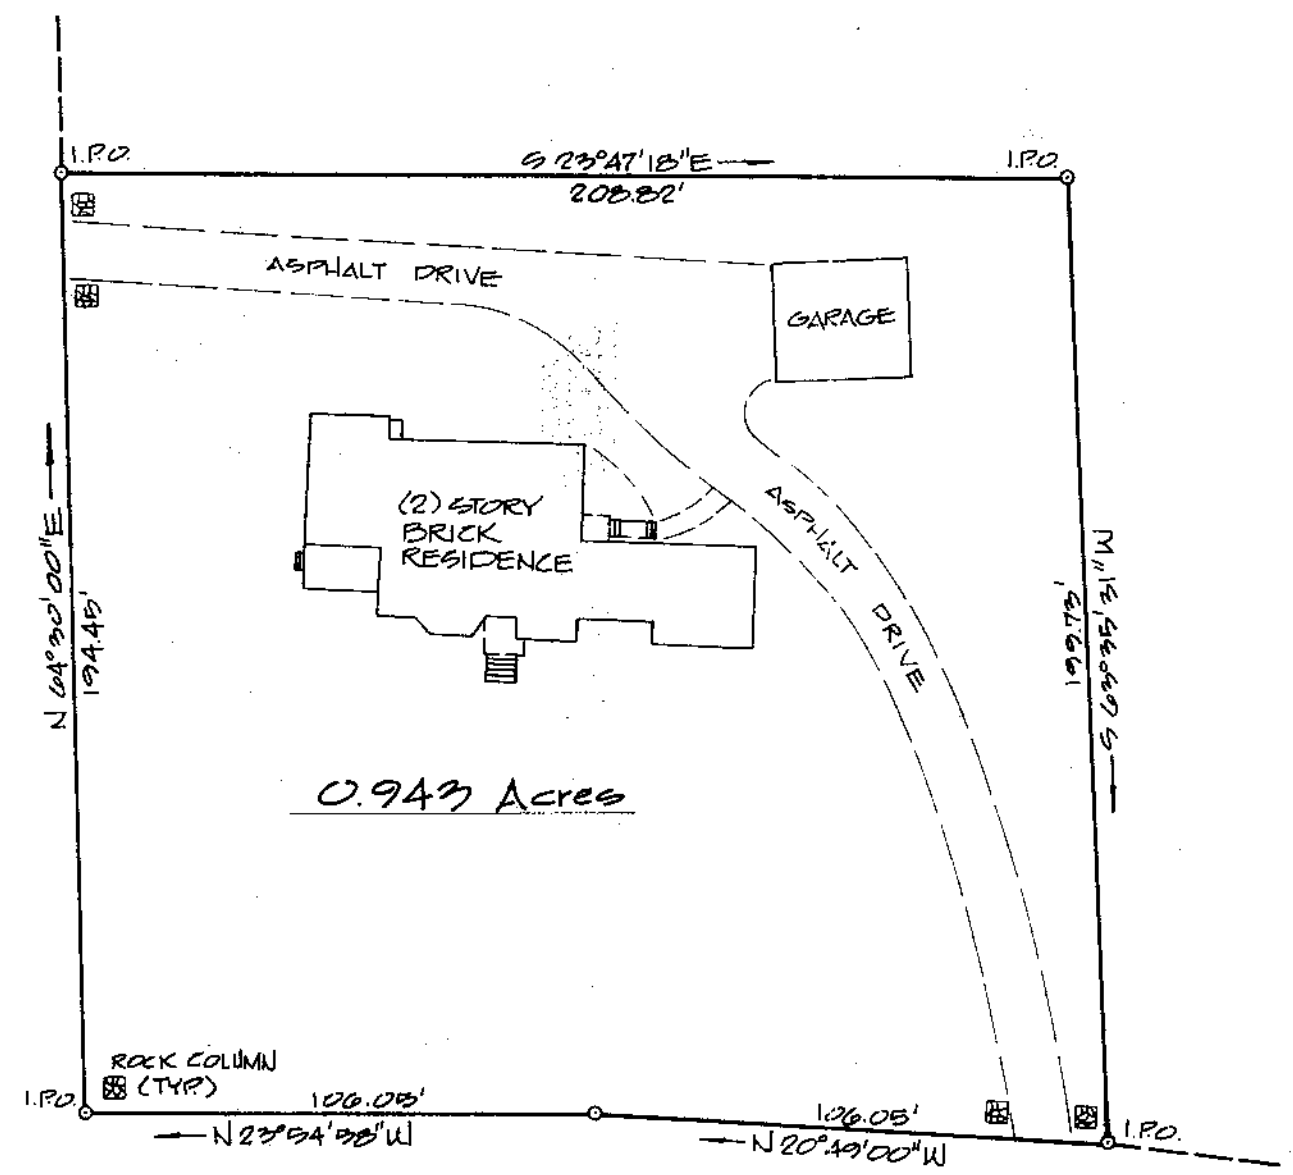

MAIL TO
 GADDY & DAVENPORT
 P. O. BOX 10267
 GREENVILLE, S. C.
 29603

PREPARED
 JAN 11 1980
 ENRIGHT
 SURVEYING, INC.

FILED
 GREENVILLE CO. S. C.
 JAN 14 4 38 PM '80
 DORRIS C. WALKERSLEY
 R.M.C.


JAN 1 1980

21959
 7-0-97
[Handwritten signature]

I HEREBY CERTIFY THAT THE RATIO OF PRECISION OF THE FIELD SURVEY IS 1/4,000 AS SHOWN HEREON AND THE AREA WAS DETERMINED BY D.M.Q. METHOD OF AREA CALCULATION.

Therrell M. Amick
 SURVEYOR'S SIGNATURE

4032
 S.C. REG. NO.

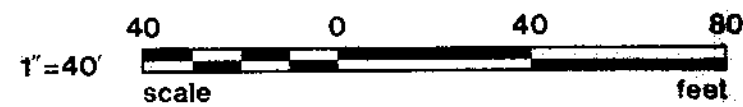

REV.	DATE	BY	DESCRIPTION	APP.
1	1/11/80	W.H.P.	ISSUED FOR REVIEW	
REVISION				

A SURVEY MADE FOR:
JACQUELYN CLARKSON WILLIAMS
 GREENVILLE, SOUTH CAROLINA

enwright associates, inc.
 engineers planners surveyors
 GREENVILLE, SOUTH CAROLINA

DATE: 1/11/80
 SCALE: 1"=40'
 DRAWN: JAW
 DESIGNED: JAW
 CHECKED: JAW
 FILE NO: 80501