


FILED
GREENVILLE CO. S. C.

OCT 4 1 44 PM '79 10° 24' E 120.0'

DONNIE S. TANKERSLEY
R.M.C.

20' UTILITY EASEMENT

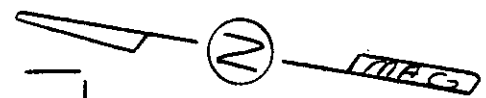

193

194

195

N 79° 21' E 151.11'

S 80° 26' W 150.76'

30' B.L.

420' ± TO PEBBLECREEK DR.

N 11° 33' W 100.05'

APPLEJACK LANE

This is to certify that on August 20, 1979, I surveyed the property shown on this plat, known as Lot 194 on plat of Pebblecreek Phase I, recorded in the RMC Office of Greenville County in Plat Book 5D on page 2, and that the property lines, walls and buildings are as shown hereon; that no adjacent walls or buildings encroach or project on said premises, and that no utility lines cross this property except as shown hereon. This property is not located in a designated flood hazard area.

Drainage & utility easement 5 feet either side of all side lot lines, and 10' on rear lot lines except as otherwise shown.

✓ 7-2-25 11496

OCT 4 1979

James R. Freeland
James R. Freeland RLS & PE 4781



SEAL

**STATE OF SOUTH CAROLINA
GREENVILLE COUNTY**

PEBBLECREEK
PHASE I - LOT 194
PROPERTY OF
WILLIAM C. NEEL
E VANGELINE K NEEL

FREELAND & ASSOCIATES
Engineers • Land Surveyors

GREENVILLE, S.C.

SURVEY	J. A.
DRAWN	M. C.
CHECK	M. C.
SCALE	1" = 40'
DATE	8-20-79
DWG. NO.	79-3907