


MICROFILMED


MAG

PITTMAN

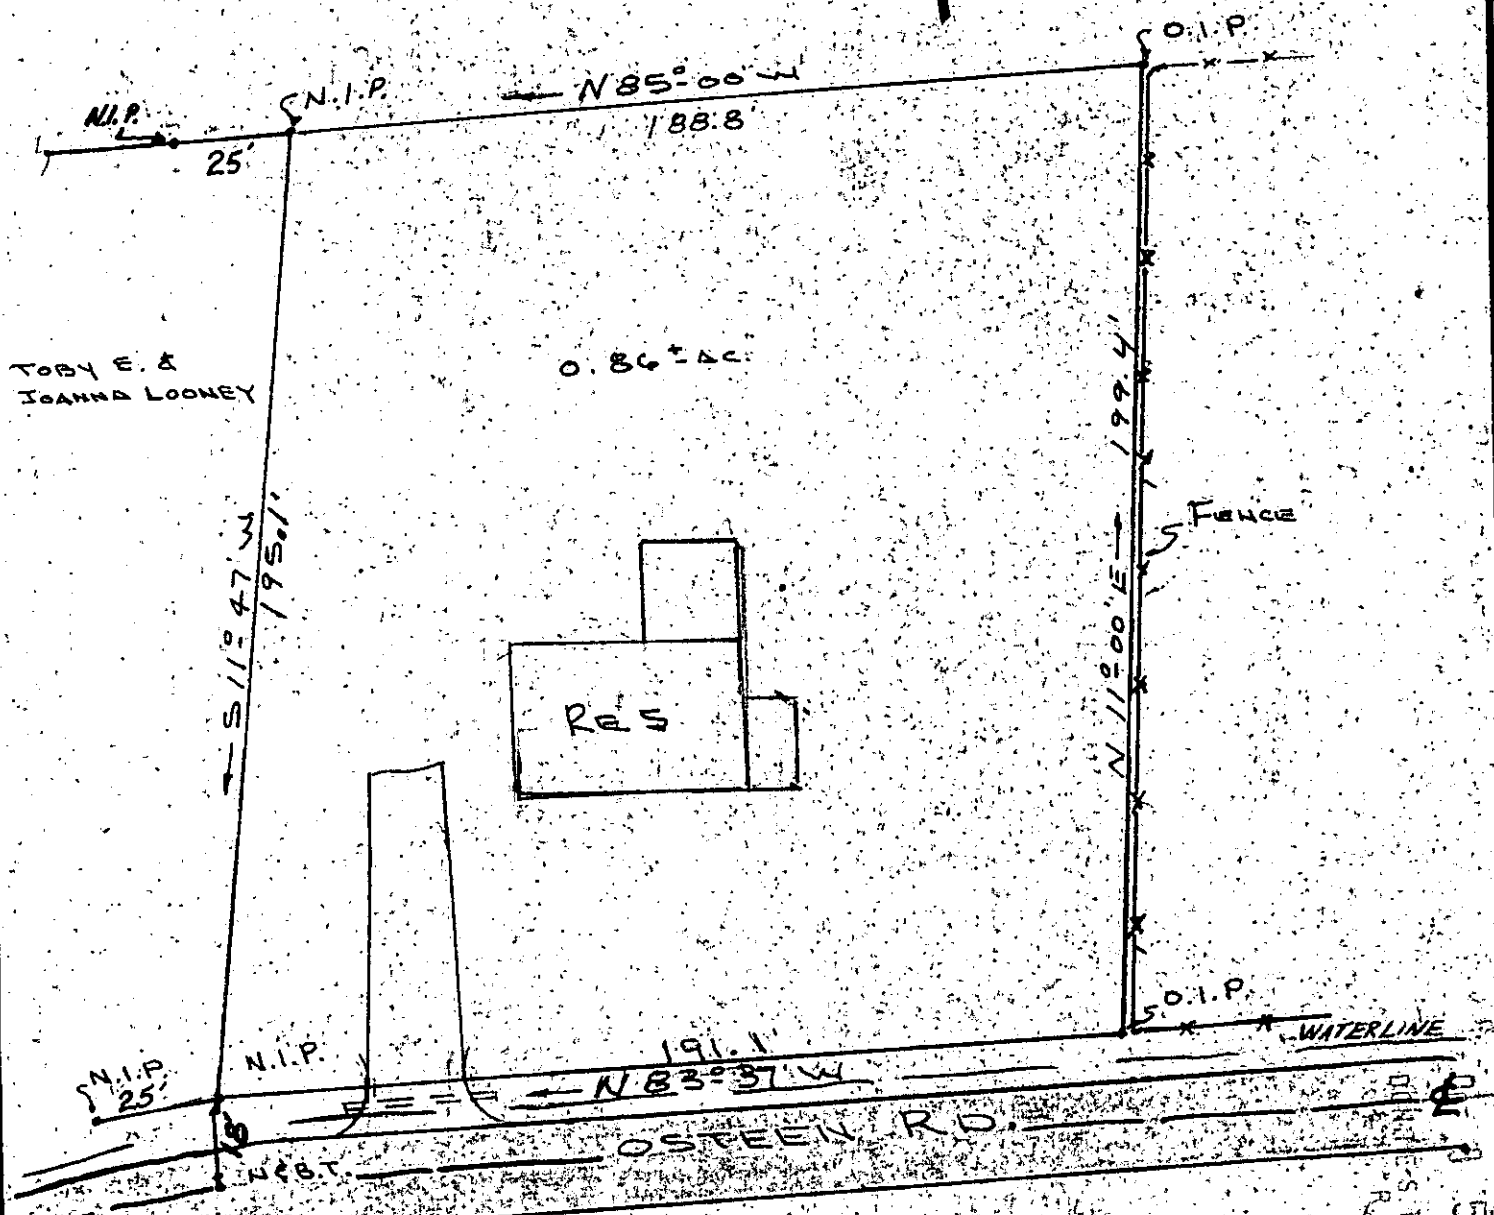


TOBY E. & JOANNA LOONEY

0.86 ± AC.

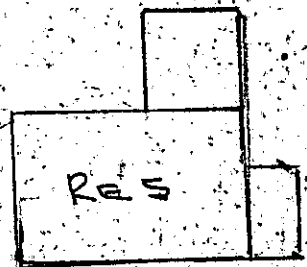

Fence

WATERLINE

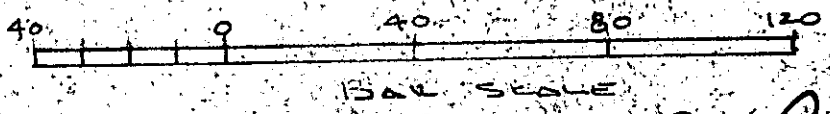

SCALE

7-R-40

GREENVILLE CO. S.C. 5 01 PM '79
R.M.C. JANKERSLEY

FILED GREENVILLE CO. S.C.

GROVE TOWNSHIP
GREENVILLE COUNTY
PIEDMONT, SC

REF: BLOCK BOOK 615.2-1
D. BK. 238-160
HOTEL DIVISION OF LAND

I CERTIFY THIS PROPERTY HAS BEEN SURVEYED, AND IS AS SHOWN. 12013

Kenneth J. Gould
S.C. REG. NO. 4035

Seal



PROPERTY
OF
TOBY E. AND
JOANNA LOONEY

GOULD & ASSOC
SURVEYORS
TAYLORS, S.C.

Drawn By	K. GOULD, JR.
Checked By	K.G.
Scale	1" = 40'
Date	10/17/79
File No.	147
Dwg. No.	5.0001