

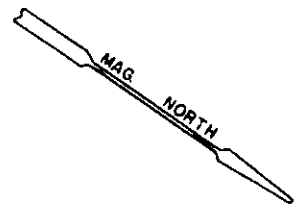
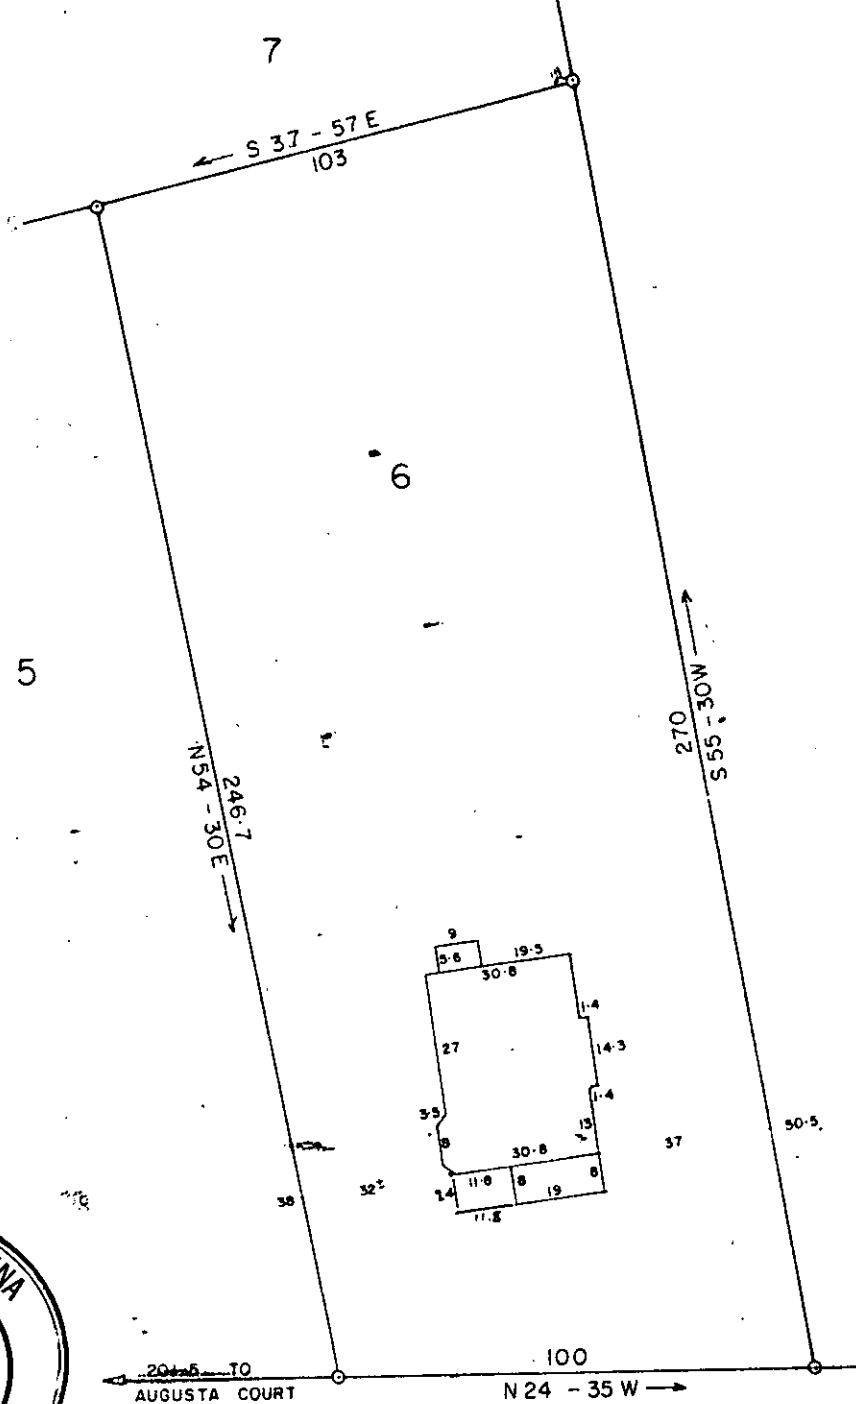


MICROFILMED

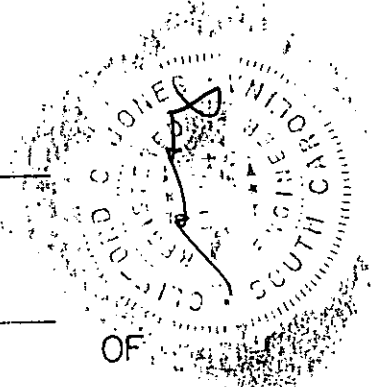

GREENVILLE CO. S.C.  
 OCT 11 3 42 PM '79  
 DONNIE S. TANKERSLEY  
 R.M.C.

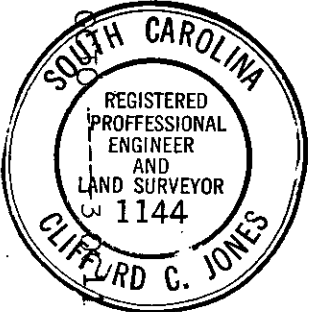

NOTE; This lot does not lie in a flood plane.

PROPERTY OF

FREDERICK E. JONES

LINDA T. JONES

GREENVILLE COUNTY, S. C.

1979  
 I certify that on the 8 day of OCT.  
 1979 I surveyed the property shown on this  
 plat, being LOT 6 Blk. A. AUGUSTA COURT  
 recorded in Plat Book F  
 124 of the R.M.C. Office for Greenville County,  
 S. C., and that the property lines, walls and  
 buildings are as shown hereon; that the buildings  
 located on said lot do not encroach or project on  
 adjacent streets or property; and that no adjacent  
 buildings or walls encroach or project on said  
 premises, and that no utility lines cross this  
 property.

*Clifford G. Jones*  
 Reg. Engineer No. 1144 S.C.

12263

SCALE 1" = 40' OCT. - 8 - 79

7-R-50 ✓

OCT 11 1979