

ALIGNED

FILED
GREENVILLE CO. S. C.


OCT 17 1 16 PM '79

DONNIE S. TANKERSLEY
R.M.C.

REECE



N 13 - 13 E →
102.8

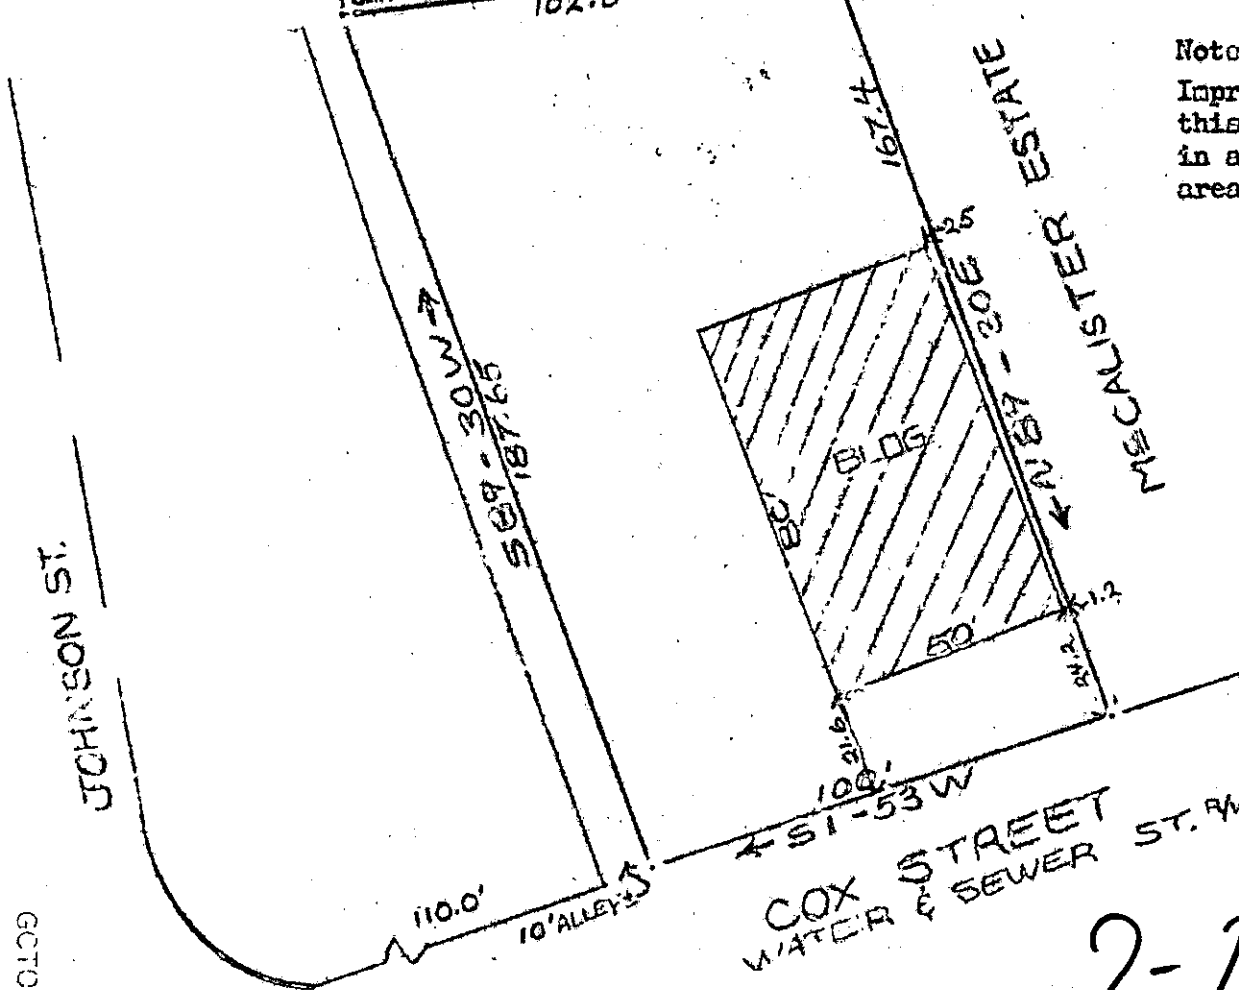

Note:
Improvements on
this lot are not
in a flood hazard
area.

JOHNSON ST.

GCTO --- 1 OCT 17 79

COX STREET
WATER & SEWER ST. RW
12975

2-R-70

PROPERTY OF OCT 17 1979
JAMES C. JETER, JR.
GREENVILLE, S.C.
SCALE: 1" = 40' 15 OCT 1979

This is to certify that on the 15th day of October, 1979, I surveyed the property shown on this plat, being known as PROPERTY OF JAMES C. JETER, JR. and recorded in the RMC Office Greenville County, S. C., in Plat Book at Page ; and that the property lines, walls and buildings are as shown hereon, and that the walls and buildings located on said lot do not encroach or project on adjacent street or property, and that no adjacent walls or buildings encroach or project on said premises, and no power lines cross this property except as shown hereon.

R. B. Bruce
R. B. Bruce, RLS #1952

CAROLINA SURVEYING CO.
112 MANLY ST
GREENVILLE, S.C.

3.0001

211/57A

57 - 1 - 12.1