

MICROFILMED

S 27-35 W 210.0'

"FORMERLY THACKSTON"


FILED ONE ACRE

GREENVILLE CO. S. C.

OCT 25 2 51 PM '79

DONOR S. TANKERSLEY R.M.C.

"SEPTIC SYSTEM"

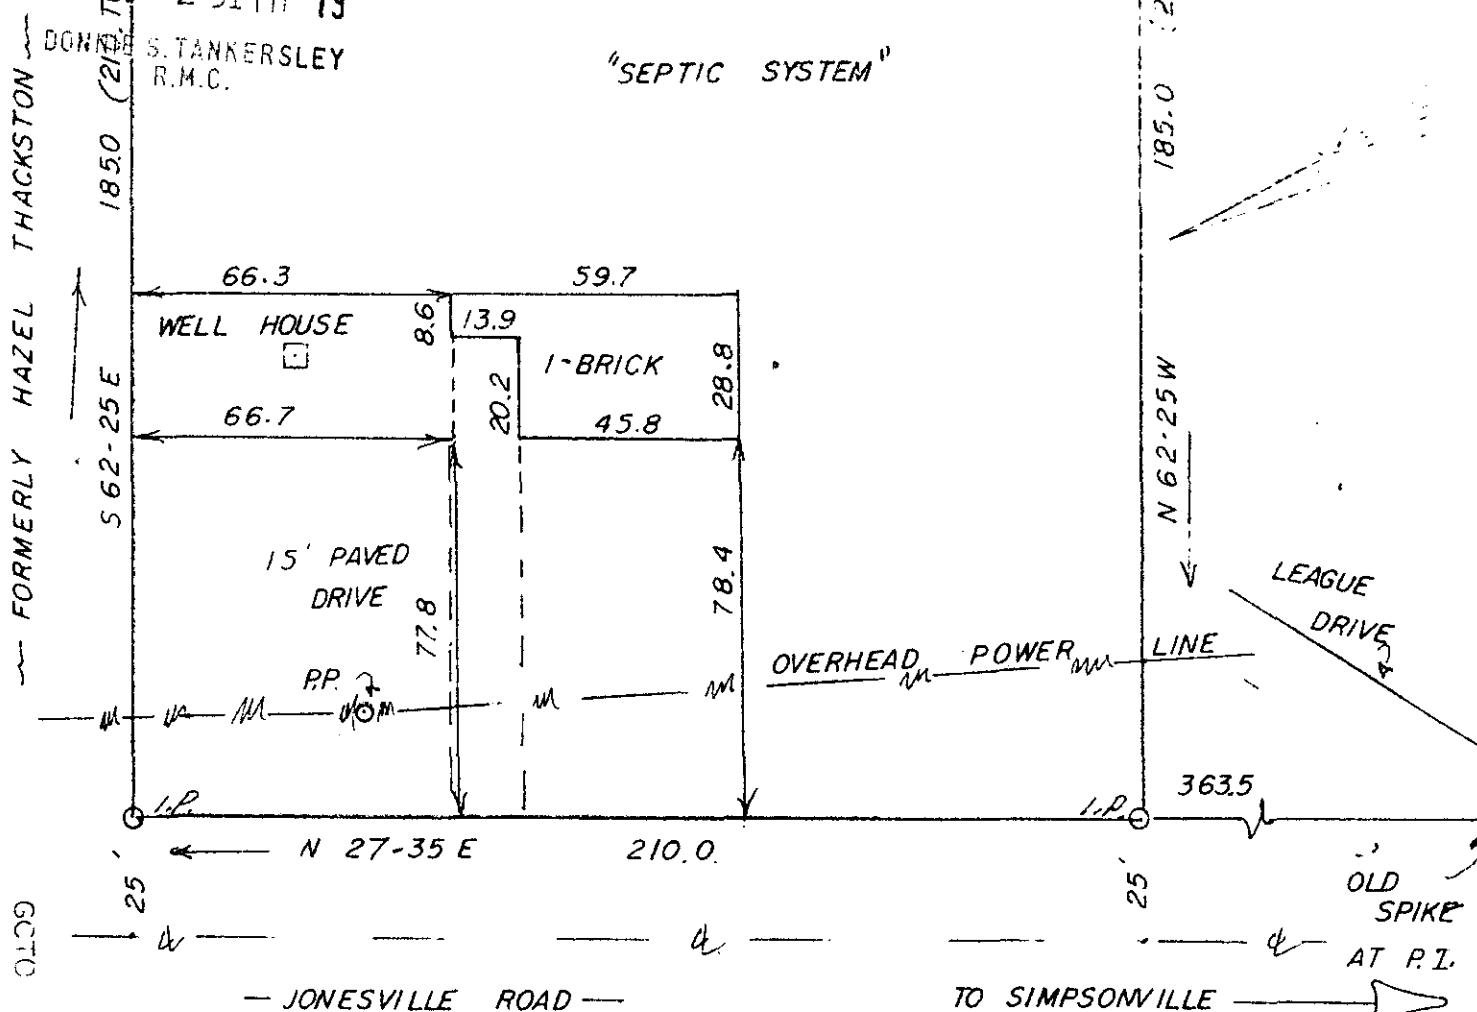

FORMERLY HAZEL THACKSTON

JONESVILLE ROAD TO SIMPSONVILLE

AT THE REQUEST OF: JEFFREY S. MILLS and LISA J. MILLS

THIS IS TO CERTIFY THAT ON THE 16TH DAY OF OCTOBER, 1979, I SURVEYED THE PROPERTY SHOWN ON THIS PLAT, BEING KNOWN AS LOT (NONE) ON PLAT OF (NONE), AND RECORDED IN THE R. M. C. OFFICE GREENVILLE COUNTY, S. C. IN (NONE) BOOK (NONE) AT PAGE _____; AND THAT THE PROPERTY LINES, WALLS, AND BUILDINGS ARE SHOWN HEREON, AND THAT THE WALLS AND BUILDINGS LOCATED ON SAID LOT DO NOT ENCRANCH OR PROJECT ON ADJACENT STREETS OR PROPERTY, AND THAT NO ADJACENT WALLS OR BUILDINGS ENCRANCH OR PROJECT ON SAID PREMISES, AND NO POWER LINES CROSS THIS PROPERTY EXCEPT AS SHOWN HEREON.

13623

7-R-94

OCT 23 1979

"THIS IS TO CERTIFY THAT THE ERROR OF CLOSURE OF THIS SURVEY IS 1 IN CLASS "A", AND THE ACREAGE HAS BEEN DETERMINED BY THE D.M.D. METHOD."

J. D. MONTGOMERY
 R. L. S. No. _____
 Simpsonville, S.C.

GCTO 1002379 1584

3.0001