

This is to certify that on November 13, 1979, I surveyed the property shown on this plat, known as Lot 167 on plat of Brentwood Sec. 4, recorded in the RMC Office of Greenville County in Plat Book 5D on page 43, and that the property lines, walls and buildings are as shown hereon; that the building located on said lot does not encroach or project on adjacent streets or property, and that no adjacent walls or buildings encroach or project on said premises, and that no utility lines cross this property except as shown hereon. This property is not located in a designated flood hazard area.

5' utility & drainage easement each side of all side and rear lot lines


16829
7-5-14

James R. Freeland
James R. Freeland RLS & PE 4781

NOV 16 4 03 PM '79
DONNIE S. TANKERSLEY
R.M.C.

NOV 13 1979

319.2-1-95

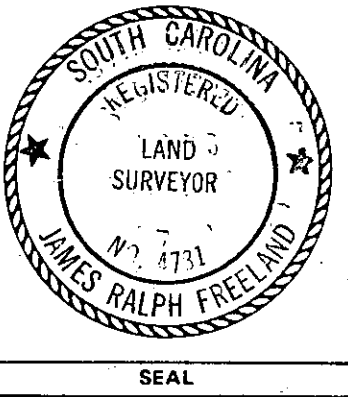

**STATE OF SOUTH CAROLINA
GREENVILLE COUNTY**

BRENTWOOD
SEC. 4 - LOT 167
PROPERTY OF
LARRY R. KUYKENDALL
SUSAN C. KUYKENDALL

FREELAND & ASSOCIATES Engineers • Land Surveyors	
GREENVILLE, S.C.	
SURVEY	L.T.
DRAWN	M.C.
CHECK	M.C.
SCALE	1" = 40'
DATE	11-13-79
DWG. NO.	79-4411