


This is to certify that on November 26, 1979, I surveyed the property shown on this plat, known as Lot 12 on plat of Woodmere, recorded in the RMC Office of Greenville County in Plat Book 6H on page 80, and that the property lines, walls and buildings are as shown hereon; that the building located on said lot does not encroach or project on adjacent streets or property, and that no adjacent walls or buildings encroach or project on said premises, and that no utility lines cross this property except as shown hereon. This property is not located in a designated flood hazard area.

drainage and utility easement each side of all side and rear lot lines.

*James R. Freeland*  
James R. Freeland RLS & PE 4781

NOV 26 1979

✓ 7-5-45  
17635

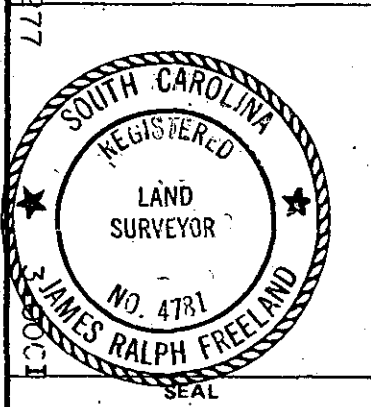

**STATE OF SOUTH CAROLINA  
GREENVILLE COUNTY**

**WOODMERE  
LOT 12  
PROPERTY OF  
LUCIUS M. CLINE III**

**FREELAND & ASSOCIATES**  
Engineers • Land Surveyors

GREENVILLE, S.C.

SURVEY	DCH
DRAWN	MLC
CHECK	MC
SCALE	1" = 40'
DATE	11-20-79
DWG. NO.	79-4436

NOV 26 1979 1477