MICROFILMED

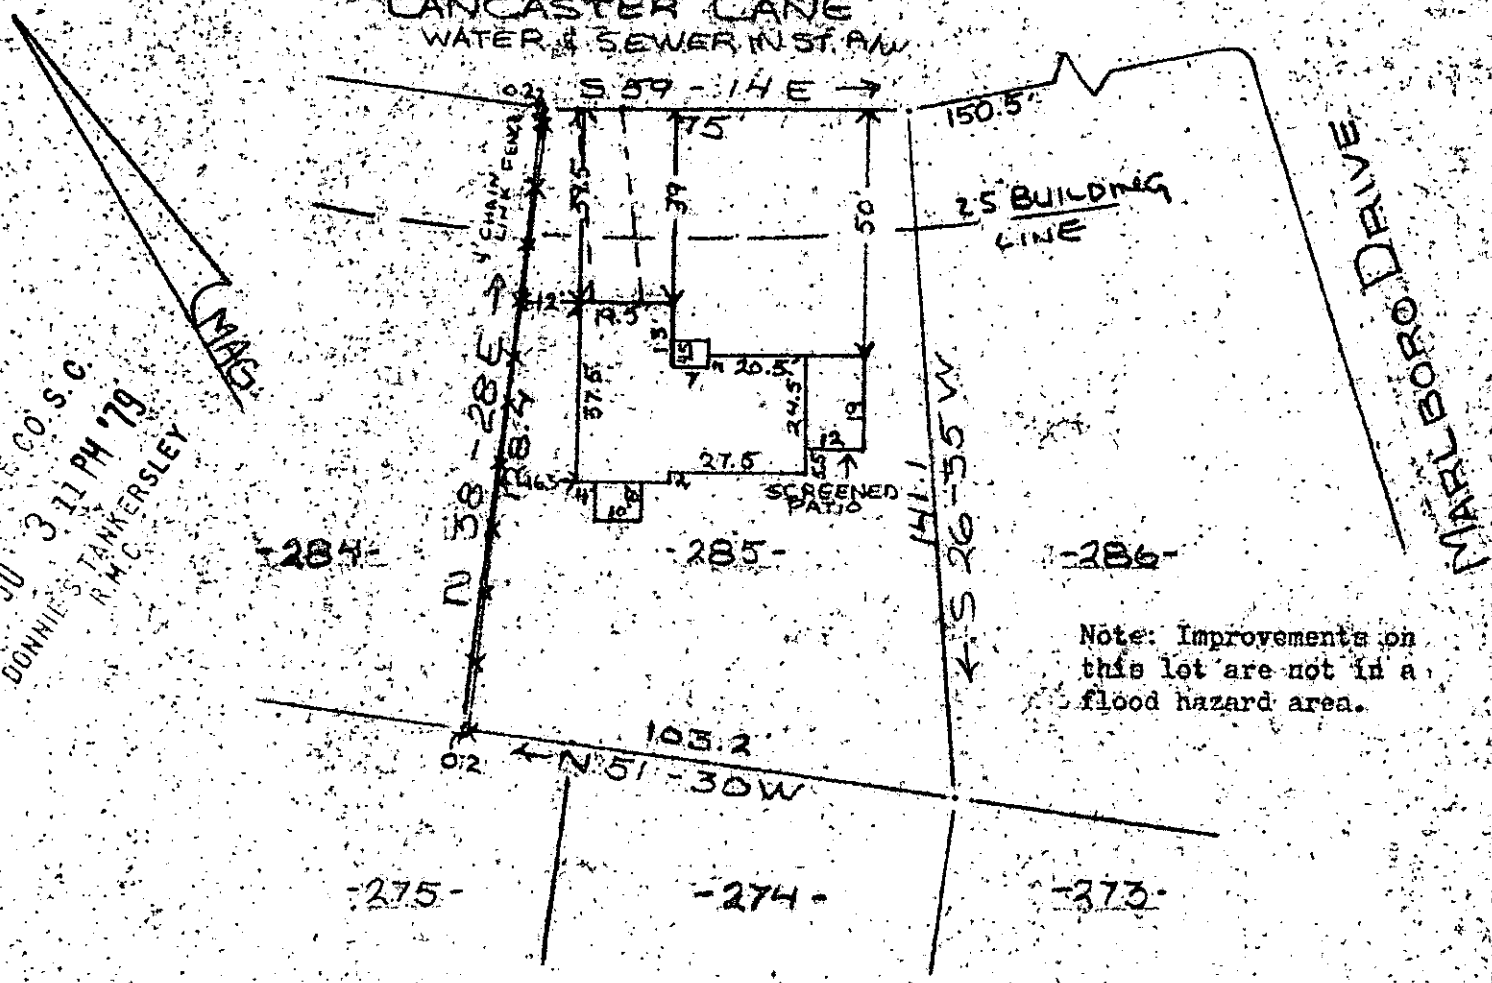

Note: Improvements on this lot are not in a flood hazard area.

PROPERTY OF
MICHAEL W. THOMPSON & JOY D. THOMPSON
GREENVILLE, S.C.
SCALE: 1"-40' 20 NOV 1979

This is to certify that on the 20th day of November, 1979, I surveyed the property shown on this plat, being known as lot 285 on plat of SECTION NO. 3 BELLE MEADE and recorded in the RMC Office Greenville County, S. C., in Plat Book " GG " at Page 187; and that the property lines, walls and buildings are as shown hereon, and that the walls and buildings located on said lot do not encroach or project on adjacent street or property, and that no adjacent walls or buildings encroach or project on said premises, and no power lines cross this property except as shown hereon.

R. B. Bruce

R. B. Bruce, RLS #1952

7-5-60 18264

CAROLINA SURVEYING CO.
112 Manly St.
Greenville, S. C.

NOV 30 1979

GREENVILLE CO. S. C.
NOV 30 3 11 PM '79
DONNIE S. TANKERSLEY
R.M.C.

GCTO -- 241

3.00CI