MICROFILMED

FILED
GREENVILLE CO. S. C.
JAN 2 3 58 PM '80
DONNIE S. TANKERSLEY
R.M.C.

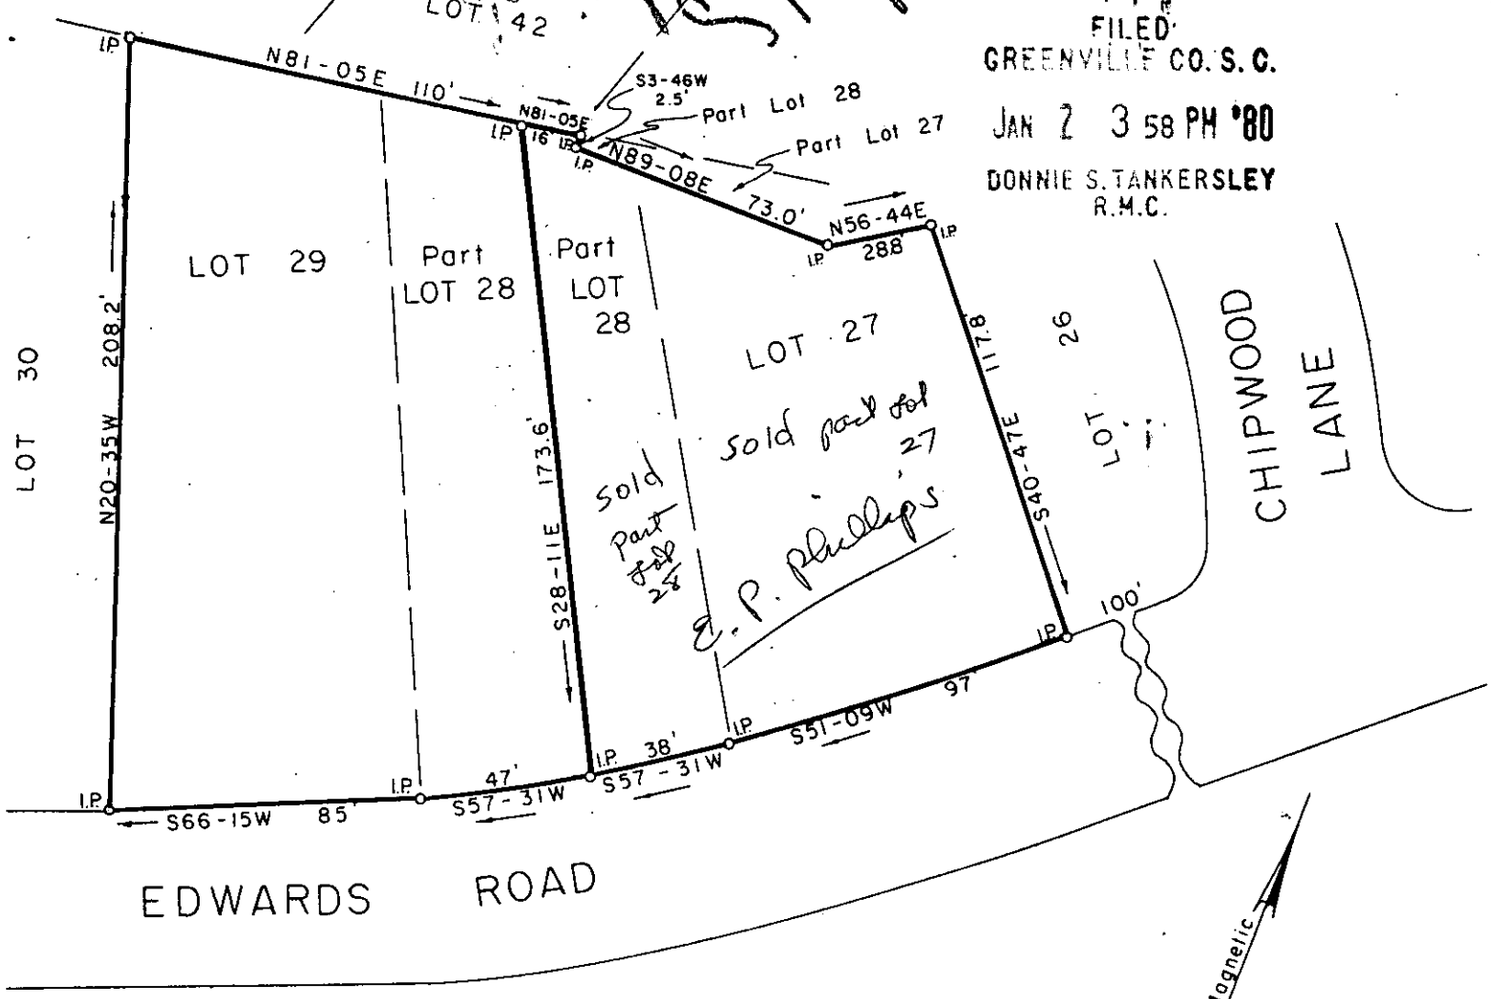

7T-41

20959

PROPERTY OF

IRENE D. DUCKER

GREENVILLE CO., S.C.

Scale 1" = 50' August, 1979

DALTON & NEVES CO., ENGINEERS

121 MANLY STREET

GREENVILLE, S. C.

SOUTH CAROLINA REGIS. PROF. ENG. & LAND SURVEYOR 6266 WILLIAM B. FANT

S. C. Reg. No. 6266 William B. Fant

GCTO -----2 DE31 79 105

3.00CI