MICROFILMED

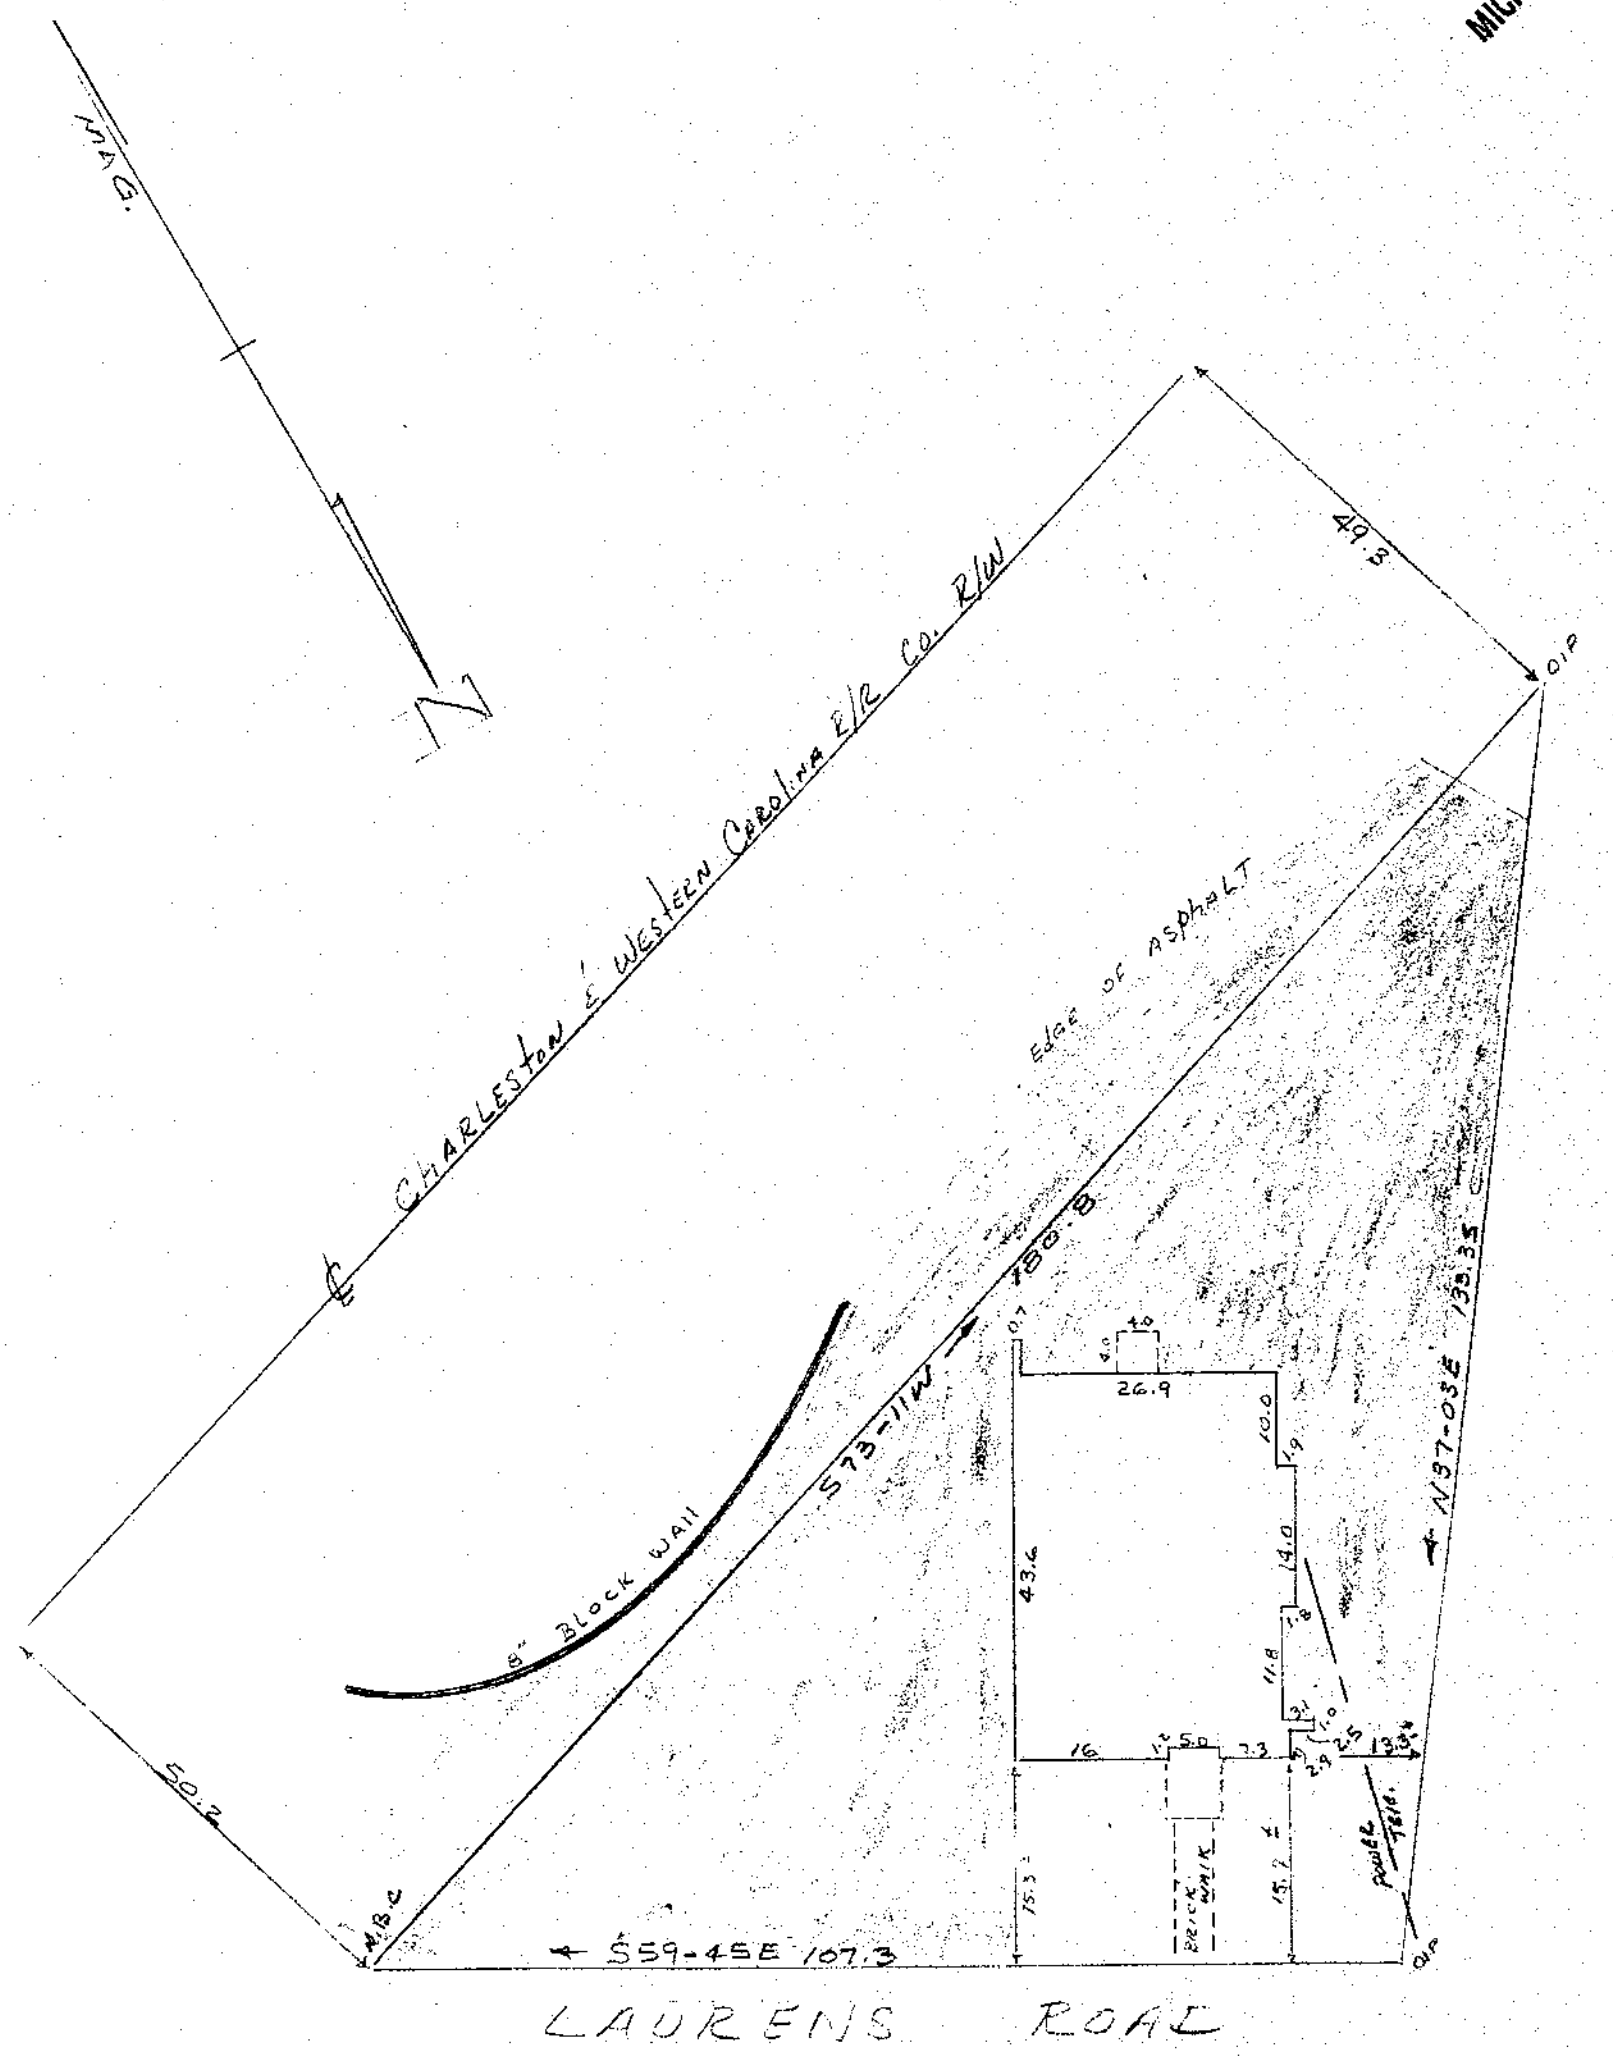

PROPERTY OF

THE HENDERSON COMPANY INC

GREENVILLE, South Carolina

MAY 9, 1980 SCALE 1" = 20'

This is to certify that on May 9, 1980 I surveyed the property shown on this plat, known as Lot 11 as shown recorded in the RMC Office for Greenville Co. on Sheet 4A, Block 2, and that the property lines, walls and building are as shown hereon and that the building located on said lot does not project nor encroach an adjacent streets or property except as shown hereon and that no adjacent walls or buildings project nor encroach on said lot and that no utility lines cross this lot except as shown hereon or for service thereto and that this lot is not within a flood hazard area.

7-11-96

Survey by Clarkson Surveying

H. C. Clarkson Jr.
SCRLS No 2589

DONNIE S. TANKERSLEY
R.M.C.
FILED
GREENVILLE CO. S.C.
'80 MAY 15 3 26 PM

33333

MAY 15 1980

STATE OF SOUTH CAROLINA
H. C. CLARKSON, JR.
2589
REGISTERED
LAND SURVEYOR

271 03 SEC