

FILED MAG.
GREENVILLE CO. S.C.

FEB 4 2 33 PM '80
DONNIE S. TANKERSLEY
R.M.C.

GREENVILLE AIRPORT COMMISSION

MICROFILMED

0.39 ACRES

This is to certify that on January 23, 1980, I surveyed the property shown on this plat, known as Lawrence Reid, recorded in the RMC Office of Greenville County in Deed Book 1027 on page 747, and that the property lines, walls and buildings are as shown hereon; that the building located on said lot does not encroach or project on adjacent streets or property, and that no adjacent walls or buildings encroach or project on said premises, and that no utility lines cross this property except as shown hereon. This property is not located in a designated "flood hazard area."


James R. Freeland
James R. Freeland R/S & PE 4781

7V-3 ✓

FEB 4 1980

23797

NORTH PLEASANTBURG DRIVE
(291 BY PASS)
FEB 4 1980

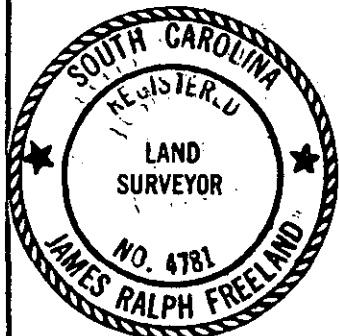

STATE OF SOUTH CAROLINA
GREENVILLE COUNTY

FREELAND & ASSOCIATES
Engineers • Land Surveyors

GREENVILLE, S.C.

PROPERTY OF

JOHN G. CHERDS

SURVEY L.T.

DRAWN B.R.

CHECK MC

SCALE 1" = 40'

DATE JAN. 23. 80

PLAT NO. 4654 3.00C1

GCTG -----2 FE. 4 80

528