
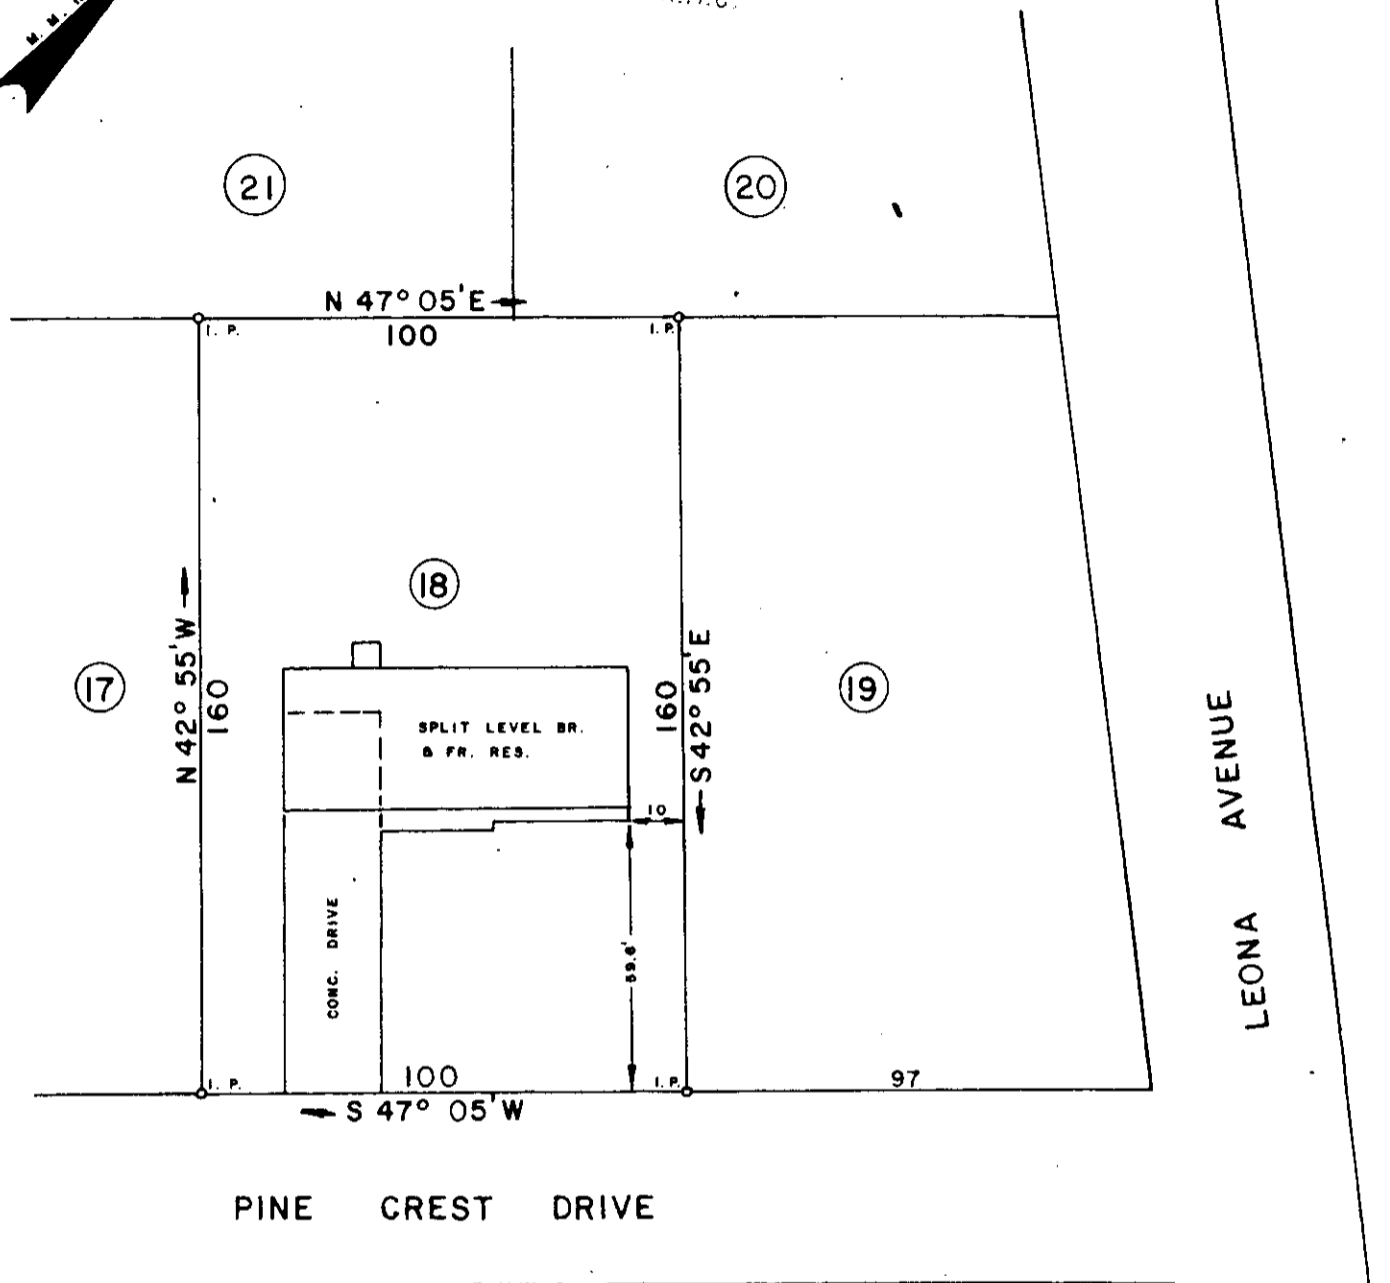


MICROFILMED

FILED
GREENVILLE CO. S. C.
MAR 19 8 44 AM '80
DONNIE S. TANKERSLEY
R.M.C.

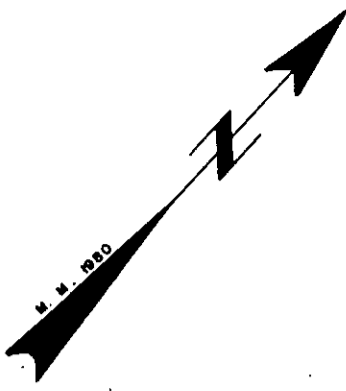

7-W-33 ✓

27769
MAR 19 1980

THIS IS TO CERTIFY THAT ON THIS DATE I SURVEYED THE PROPERTY SHOWN HEREON AND THE LINES ARE AS SHOWN, THAT THE BUILDING(S) OR WALL(S) DO NOT ENCROACH ON THE ADJOINING PROPERTY, AND THAT THE BUILDING(S) OR WALL(S) OF THE ADJACENT PROPERTY DO NOT ENCROACH ON THIS PROPERTY EXCEPT AS SHOWN. I CERTIFY THAT THIS PROPERTY ~~IS~~ IS NOT IN ANY FLOOD AREA

REF PLAT BOOK KK, PP 149.
REF DEED BOOK PP.

SURVEY FOR
BOBBY L. HAWKINS
LOCATED NEAR GREER · H. H. COX PROPERTY

COUNTY: GREENVILLE	COUNTY BLOCK MAP 288- 528.2 - 1 - 81	STATE: SOUTH CAROLINA
DATE: FEB. 26, 1980	FIELD CHIEF: B. E. HUSKEY	DRAWN BY: L. B. MORROW
REVISED:		

SCALE 1" = 40'

WOLFE & HUSKEY, INC. ENGINEERING and SURVEYING
P. O. BOX 35 · LYMAN, S. C. 29365



3020
1002