


MICROFILMED

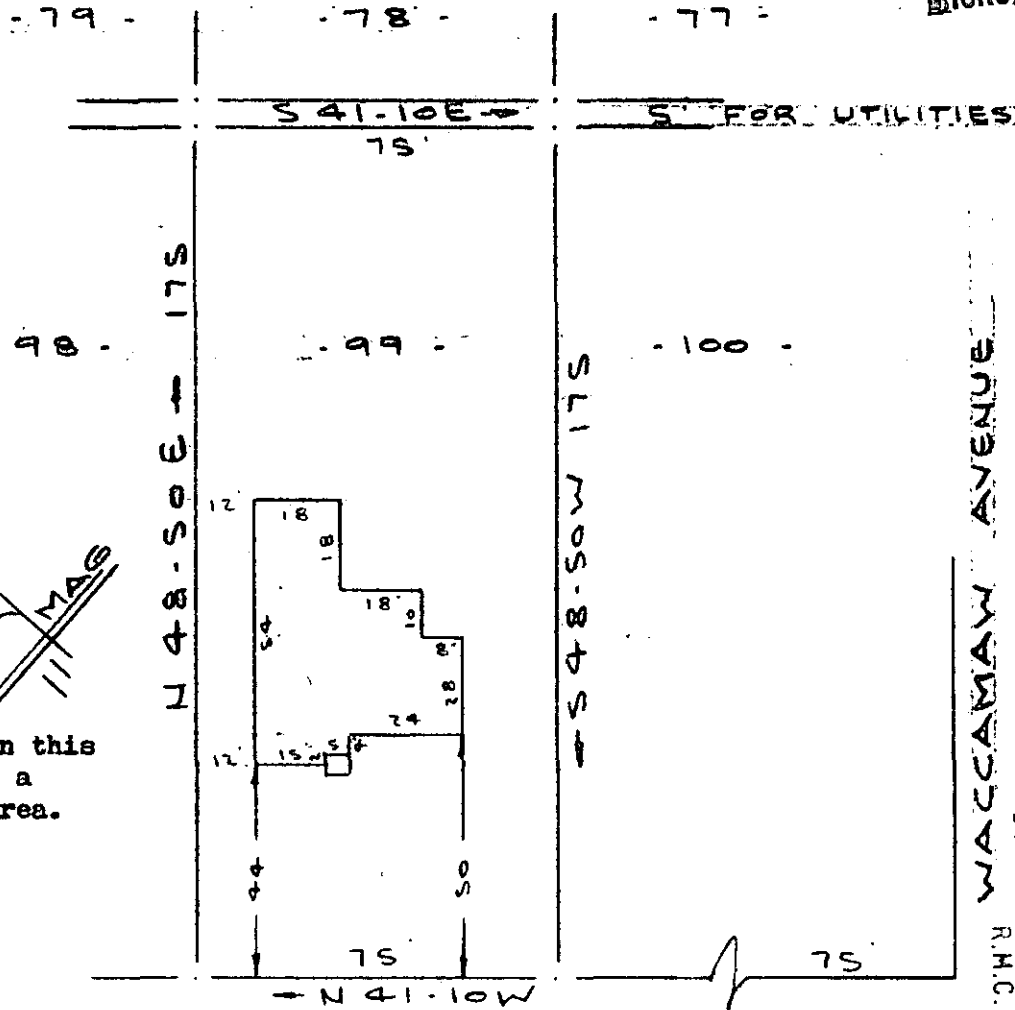

Note:
 Improvements on this lot are not in a flood hazard area.

WACCAMAW AVENUE

WACCAMAW CIRCLE
 WATER & SEWER IN ST. R/W

FILED
 GREENVILLE CO. S.C.
 MAR 19 11 30 AM '80
 DONNIE S. TANKERSLEY
 R.H.C.

PROPERTY OF
PETER SAN MIGUEL & CANDACE C. SAN MIGUEL
 GREENVILLE, SOUTH CAROLINA
 SCALE: 1" = 40'
 28 FEB 1980

This is to certify that on the 28th day of February, 1980, I surveyed the property shown on this plat, being known as lot 99 on plat of PLAT NO. 2 SUNSET HILLS and recorded in the RHC Office Greenville County, S. C., in Plat Book " P " at Page 18; and that the property lines, walls and buildings are as shown hereon, and that the walls and buildings located on said lot do not encroach or project on adjacent street or property, and that no adjacent walls or buildings encroach or project on said premises, and no power lines cross this property except as shown hereon.

7-W-39

27806

MAR 19 1980

R. B. Bruce
 R. B. Bruce, RLS #1952

CAROLINA SURVEYING CO.
 112 Manly St., Greenville, S. C.