


PHASE I

GRAN FOX COUNTRY

ROCKY CREEK IS P.L.

This plot is not within the limits of the Greenville County Subdivision Regulations and therefore requires approval by the Greenville County Planning Commission is not required.

6-19-80 *Roger J. Carter*  
 Greenville County Planning Commission

NO RECORD OF BOUNDARY SURVEY  
 THIS IS A RECONSTRUCTION  
 OF RECORD EASEMENT ALONG  
 ALL 15' OF EACH LOT LINE  
 (SEE EACH SIDE)  
 ALL LOTS OF GRANTING A BOUNDARY


△-△-△ TRANSVERSE LINES  
 15' BEARING EASEMENT TO 25  
 SHOWS 15' (CONTINUED)  
 25' ROAD SET BACK LINE


REMARKS  
 11-21-79  
 6-14-80  
 LOTS 24 THRU 29  
 1 THRU 4

"CHERRY HILL  
 PHASE I  
 -OTS 1, 2, 3, 4, 19, 24, 25, 26, 27, 28, 29


WILLIAM C E  
 ELIZABETH H. GUNNINGSTON  
 OWNERS

No OF PAGES 19 E  
 No OF LOTS 11

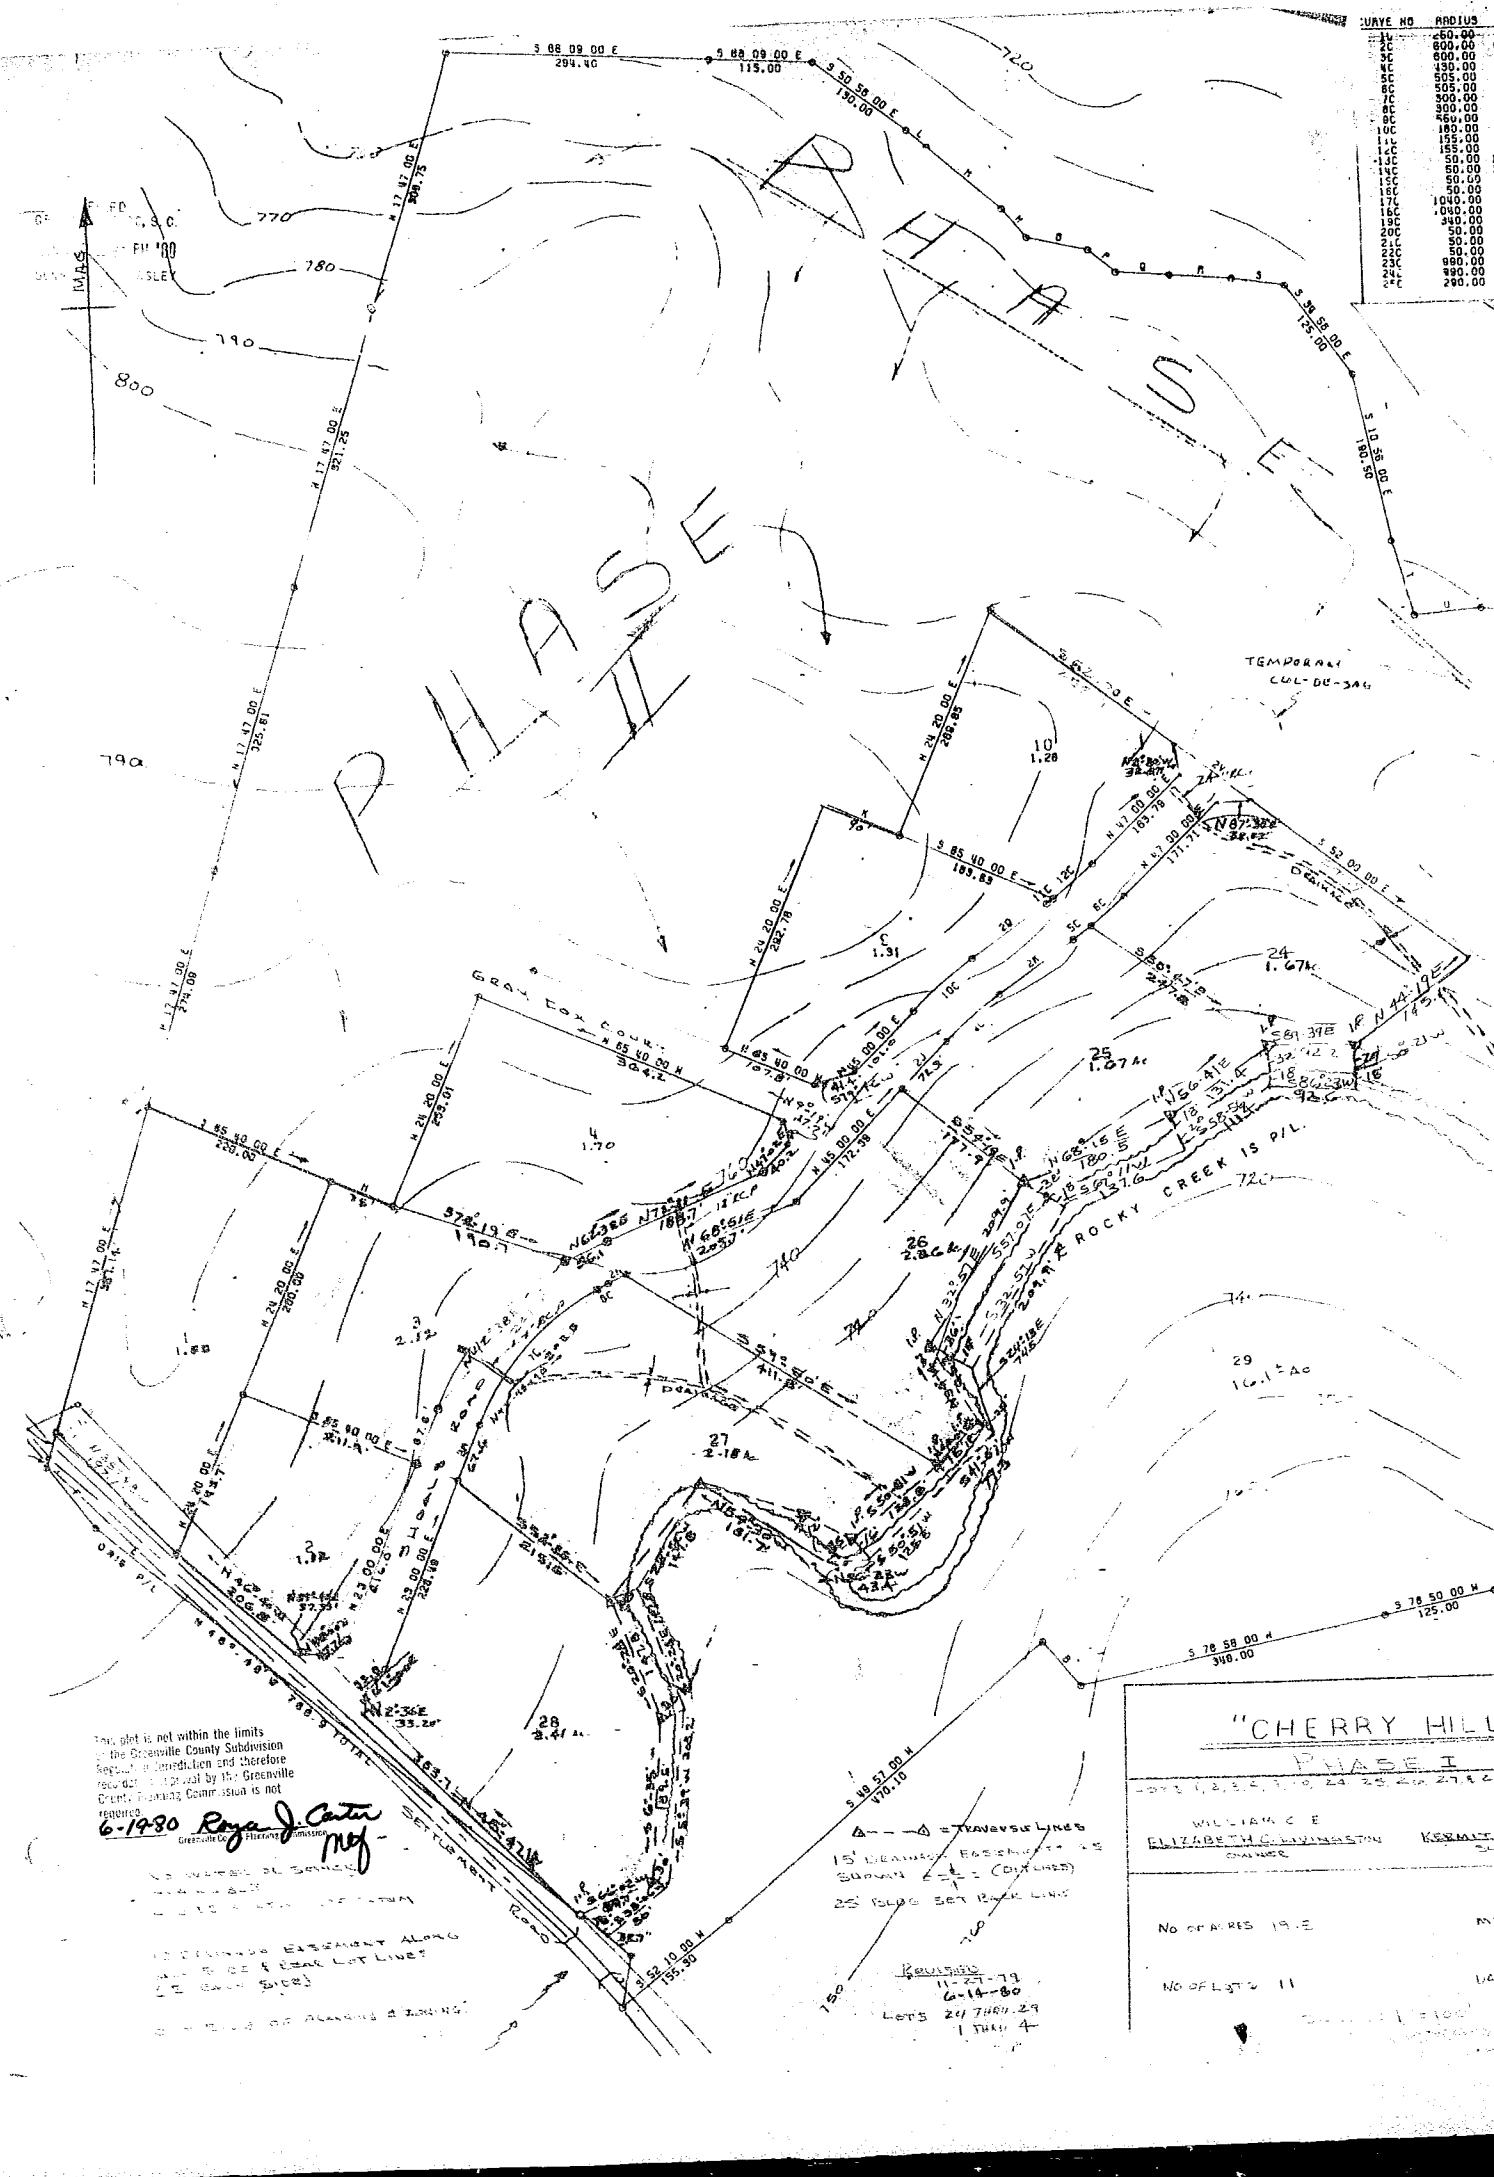

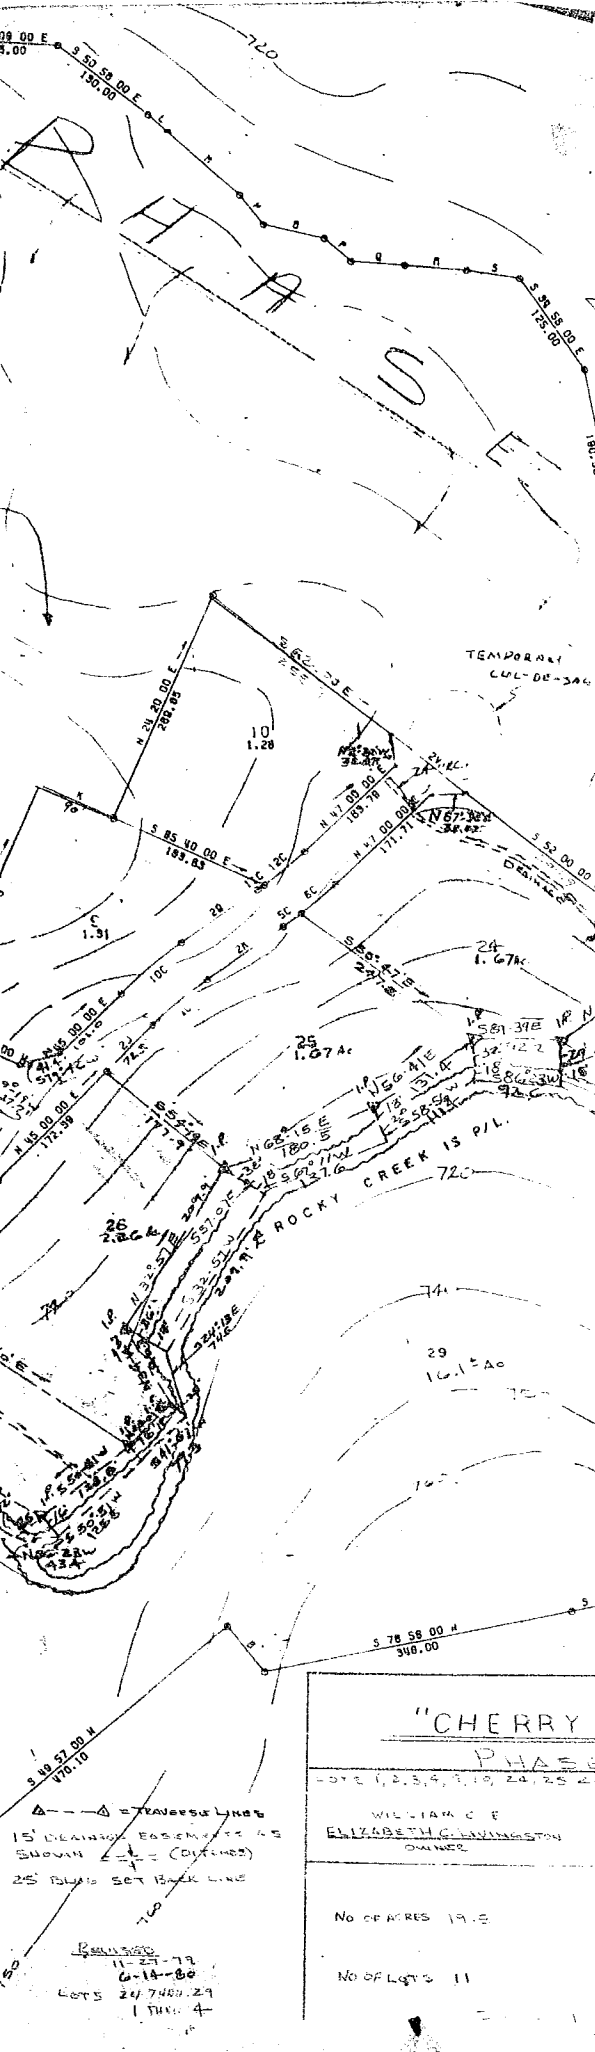


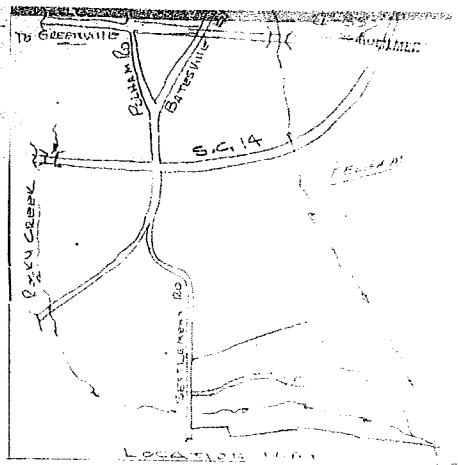


7-X-16

300330

**"CHERRY HILL"**

**PHASE I**

LOTS 1, 2, 3, 4, 5, 10, 24, 25, 26, 27, 28, 29, 30 ONLY

---

WILLIAM C E  
 ELIZABETH C WINSTON      KENNETH S BOND  
 OWNERS

---

NO OF ACRES 19.5      W/3/4 0 2 3/4

---

NO OF LOTS 11      W/2 5 9 19






