


MICROFILMED

M. M. 1980

WEST POINSETT ST.

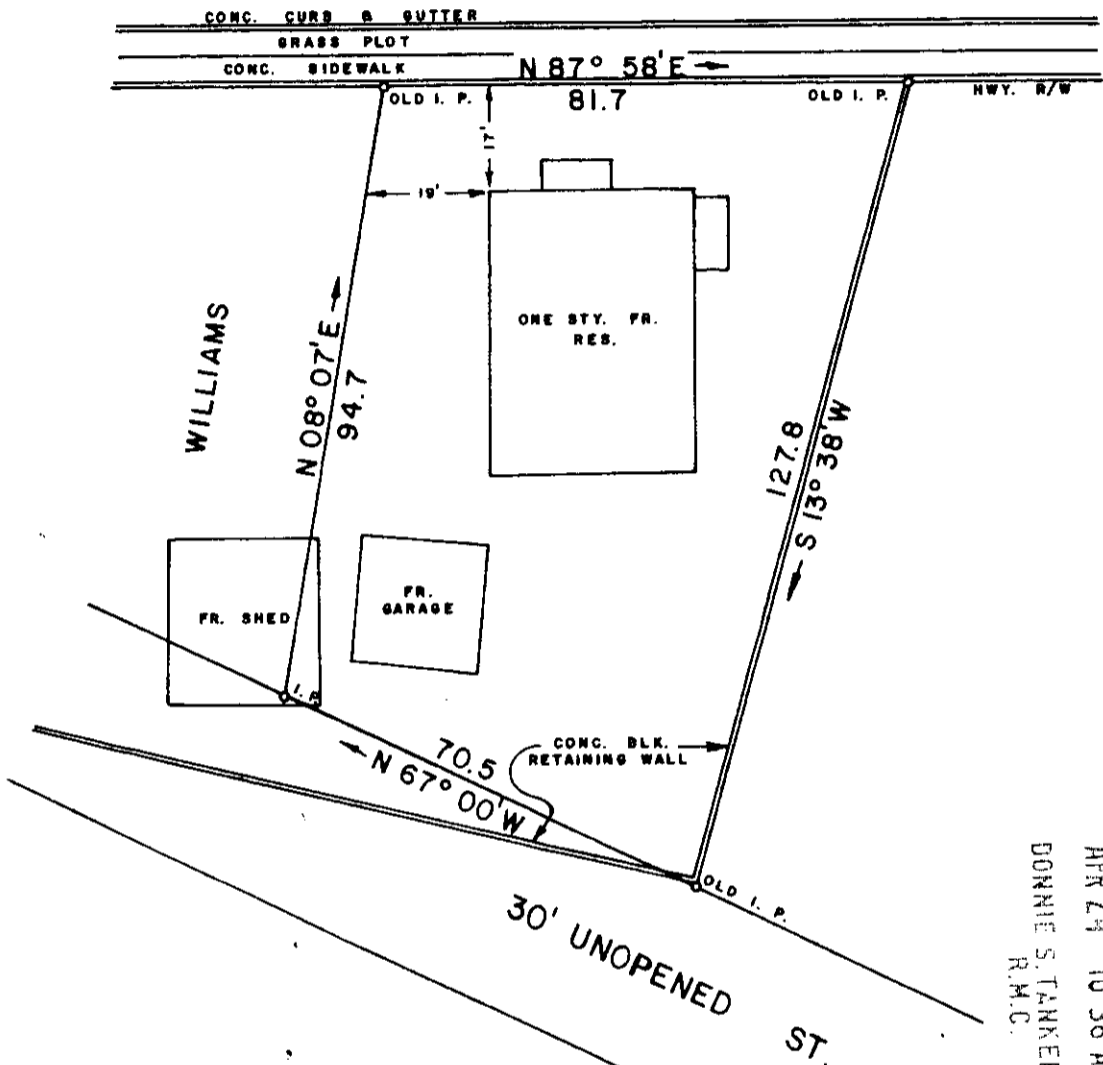

FILED
 GREENVILLE CO. S. C.
 APR 24 10 36 AM '80
 DONNIE S. TANKERSLEY
 R.M.C.

31351

7-2-32 ✓

APR 24 1980

THIS IS TO CERTIFY THAT ON THIS DATE I SURVEYED THE PROPERTY SHOWN HEREON AND THE LINES ARE AS SHOWN, THAT THE BUILDING(S) OR WALL(S) DO NOT ENCR OACH ON THE ADJOINING PROPERTY, AND THAT THE BUILDING(S) OR WALL(S) OF THE ADJACENT PROPERTY DO NOT ENCR OACH ON THIS PROPERTY EXCEPT AS SHOWN. I CERTIFY THAT THIS PROPERTY (IS IS NOT) IN ANY FLOOD AREA.

REF. PLAT BOOK PP.
 REF. DEED BOOK PP.

SURVEY FOR
DAN W. WILSON and WILLIAM S. BENSON
 LOCATED IN GREER

COUNTY: GREENVILLE	COUNTY BLOCK MAP G-9-3-1	STATE: SOUTH CAROLINA
DATE: APRIL 18, 1980	FIELD CHIEF: G. A. WOLFE	DRAWN BY: L. B. MORROW
REVIS ED:		

SCALE 1" = 30'

WOLFE & HUSKEY, INC. ENGINEERING and SURVEYING
 P. O. BOX 35 LYMAN, S. C. 29365

