


MICROFILMED

FILED
GREENVILLE CO. S.C.
MAY 1 10 01 AM '80
DONNIE S. TANKERSLEY
R.M.C.

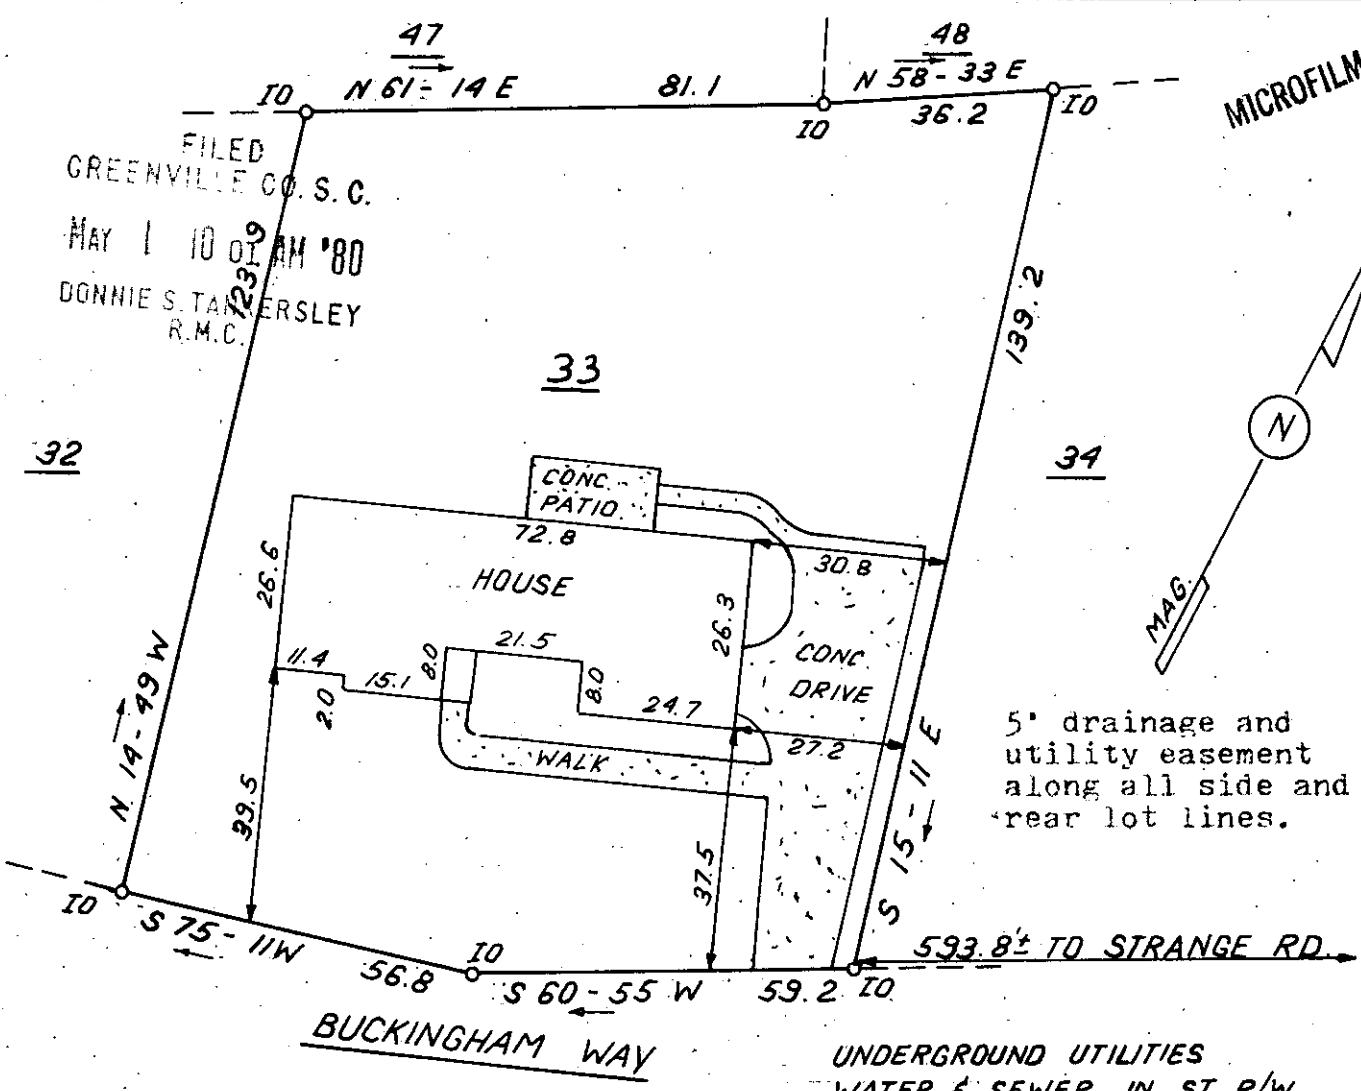

5' drainage and utility easement along all side and rear lot lines.

UNDERGROUND UTILITIES
WATER & SEWER IN ST. R/W

This is to certify that on April 18, 1980, I surveyed the property shown on this plat, known as Lot 33 on plat of Windsor Oaks Sec. 2, recorded in the RMC Office of Greenville County in Plat Book 7C on page 13, and that the property lines, walls and buildings are as shown hereon; that the building located on said lot does not encroach or project on adjacent streets or property, and that no adjacent walls or buildings encroach or project on said premises, and that no utility lines cross this property except as shown hereon. This property is not located in a designated flood hazard area.

7-Z-47 James R. Freeland

James R. Freeland RLS & PE 4781
32076
MAY 1 1980



STATE OF SOUTH CAROLINA
GREENVILLE COUNTY

WINDSOR OAKS
LOT 33 ; SECT. 2
PROPERTY OF
CHARLES C. MULLIS
B. RUTH MULLIS

FREELAND & ASSOCIATES Engineers • Land Surveyors	
GREENVILLE, S.C.	
SURVEY	L.T.
DRAWN	B.R.
CHECK	F.L.
SCALE	1" = 30'
DATE	APRIL 18. 80
DWG. NO.	4982

4873

GCTO --- 1MY.180 '926 3.00CI