AF 10505

FILED
GREENVILLE CO. S. C.
MAY 2 4 08 PM '80
DONNIE S. TANKERSLEY
R.M.C.

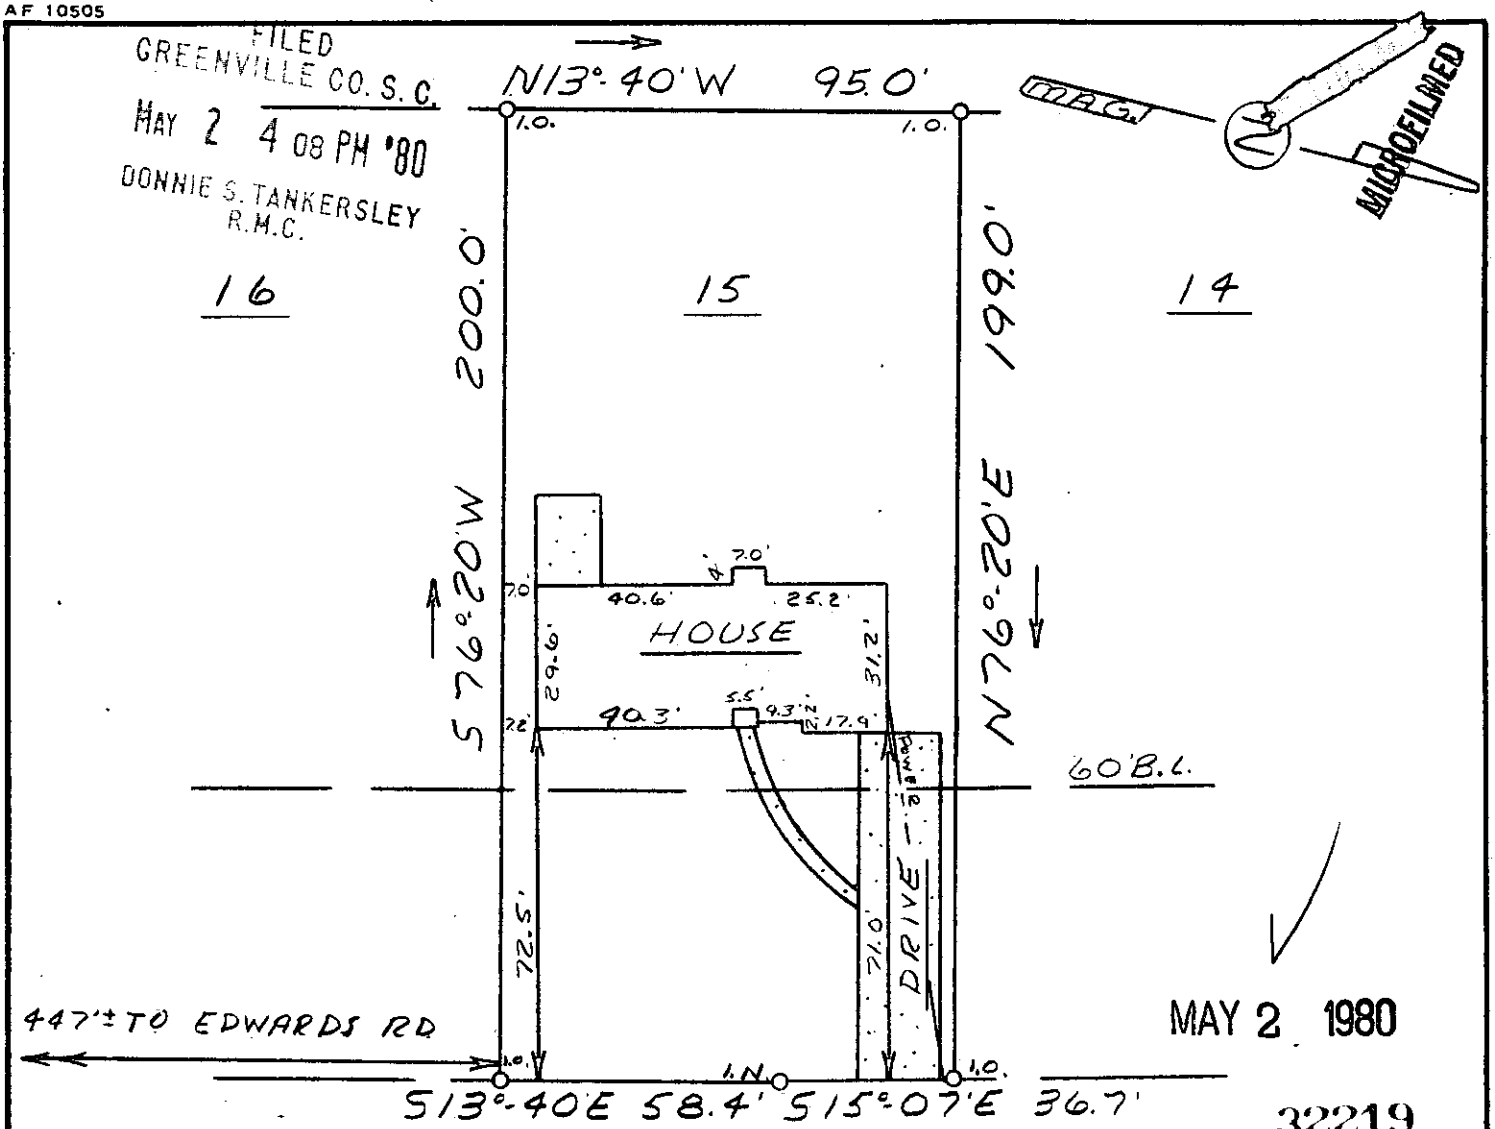

MAY 2 1980

32219

7-2-58

This is to certify that on April 28, 1980, I surveyed the property shown on this plat, known as Lot 15 on plat of Wildair Estates, recorded in the RMC Office of Greenville County in Plat Book EE on page 19, and that the property lines, walls and buildings are as shown hereon; that the building located on said lot does not encroach or project on adjacent streets or property, and that no adjacent walls or buildings encroach or project on said premises, and that no utility lines cross this property except as shown hereon. This property is not located in a designated flood hazard area.

James R. Freeland PLS & PE 4781

SOUTH CAROLINA REGISTERED LAND SURVEYOR NO. 4781 JAMES RALPH FREELAND

SEAL

STATE OF SOUTH CAROLINA
GREENVILLE COUNTY

WILDAIR ESTATES

LOT 15

PROPERTY OF

JOHN S. BOULOS

FREELAND & ASSOCIATES
Engineers • Land Surveyors
GREENVILLE, S.C.

SURVEY	L. T.
DRAWN	M. C.
CHECK	M. C.
SCALE	1" = 40'
DATE	4-28-80
DWG. NO.	80-5011