


MICROFILMED

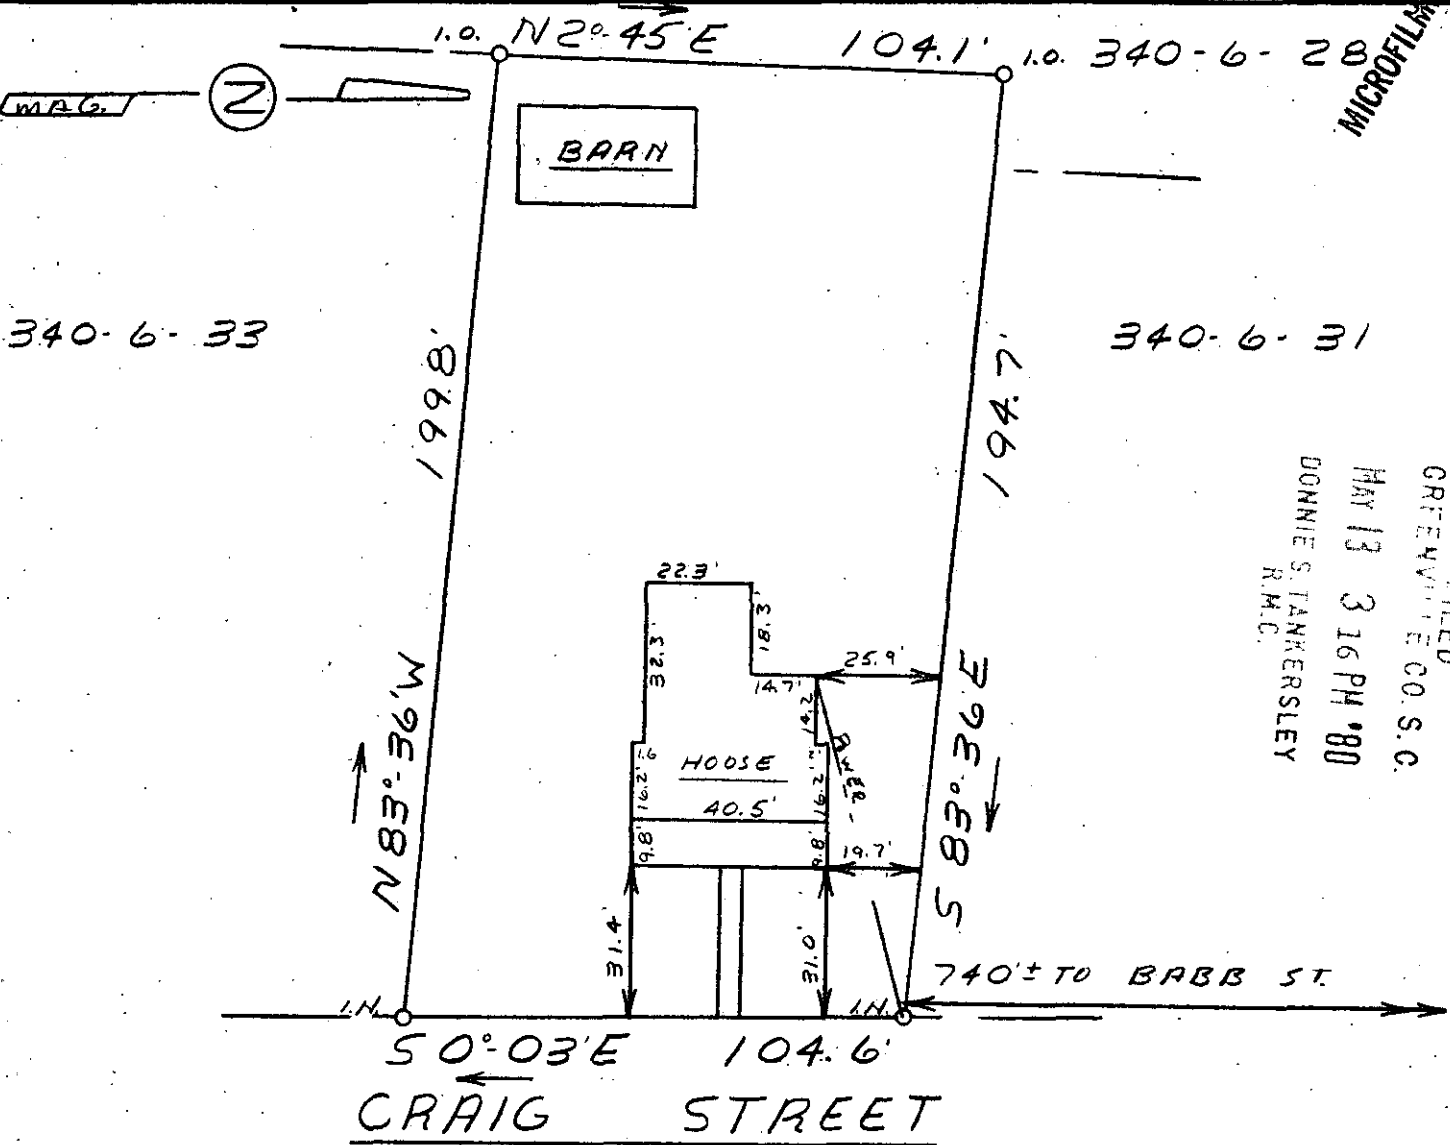

FILED
 GREENVILLE CO. S.C.
 MAY 13 3 16 PM '80
 DONNIE S. TANKERSLEY
 R.M.C.


This is to certify that on May 10, 1980, I surveyed the property shown on this plat, known as Property of Van Richard Cook and Diane E. Cook, recorded in the RMC Office of Greenville County in Deed Book 1116 on page 733, and that the property lines, walls and buildings are as shown hereon; that the building located on said lot does not encroach or project on adjacent streets or property, and that no adjacent walls or buildings encroach or project on said premises, and that no utility lines cross this property except as shown hereon. This property is not located in a designated flood hazard area.

MAY 13 1980

7-2-86

33114

James R. Freeland
 James R. Freeland RLS & PE 4781

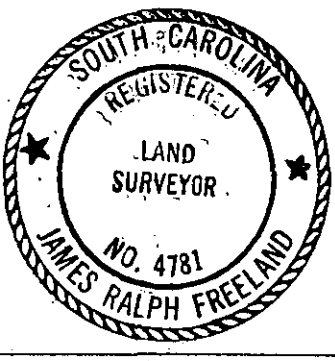

STATE OF SOUTH CAROLINA
 GREENVILLE COUNTY

PROPERTY OF
 RONALD E. NORRIS
 JACK M. HOWARD, JR.

FREELAND & ASSOCIATES
 Engineers • Land Surveyors

GREENVILLE, S.C.

SURVEY RKP
 DRAWN MC
 CHECK MC
 SCALE 1" = 40'
 DATE 5-9-80
 DWG. NO. 80-5038