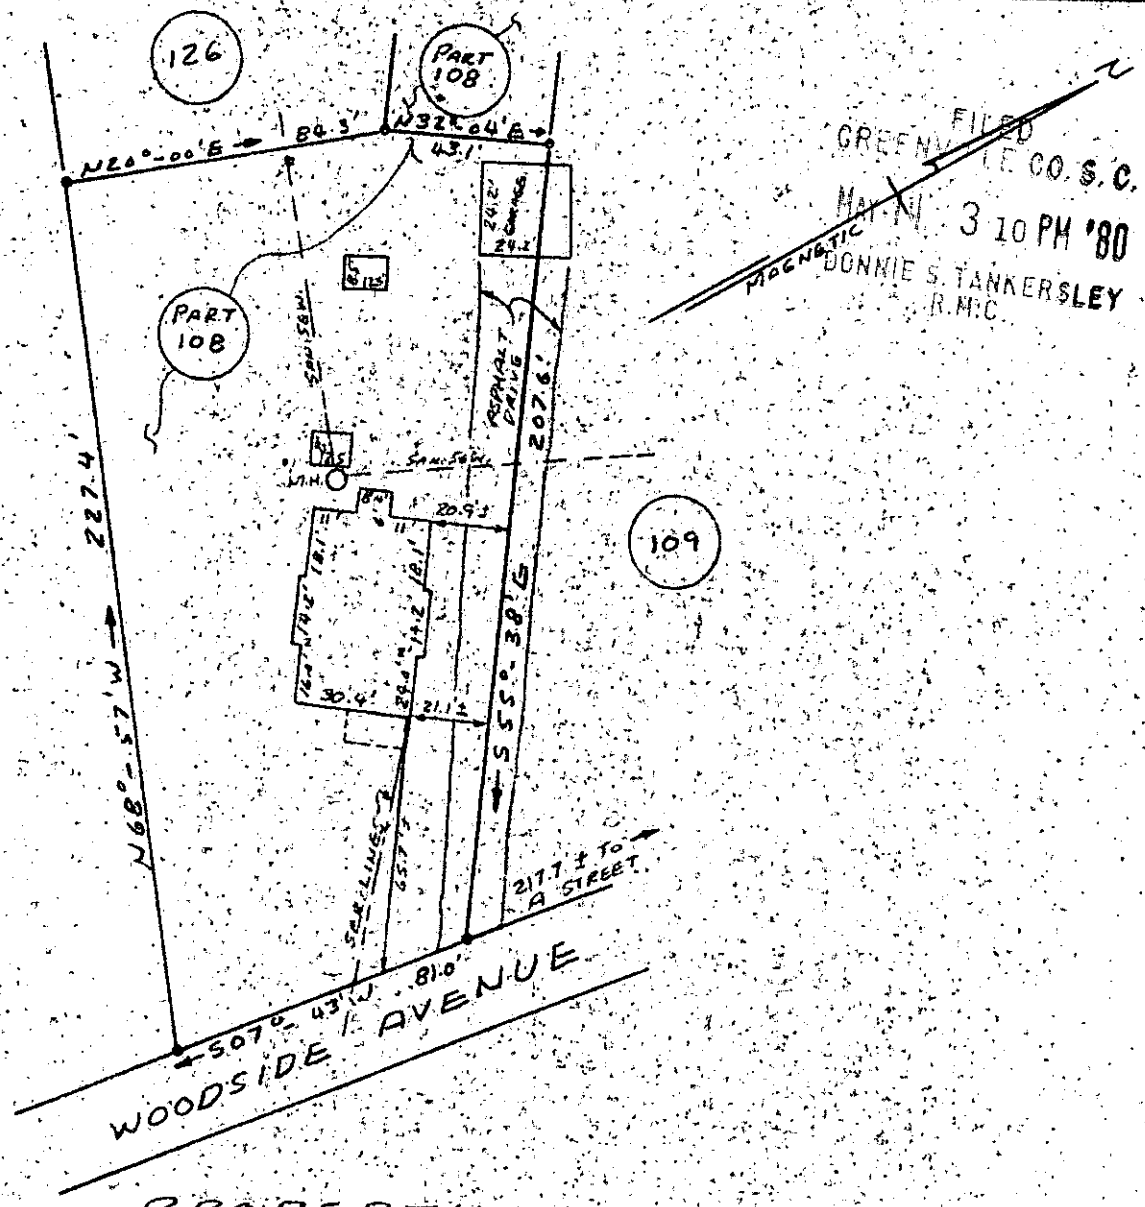

PROPERTY OF
HATTIE B. C. MASSEY &
DOROTHY L. MASSEY
GREENVILLE, SOUTH CAROLINA
MAY 10, 1980 SCALE: 1" = 50'

This is to certify that on May 10, 1980, I surveyed the property shown on this plat, known as the major portion of Lot No. 108 Section B, on a plat of Woodside Mills, recorded in Plat Book ZZZ, Page 29, in the RMC Office for Greenville County; and that the property lines, walls and buildings are as shown hereon, and that the buildings located on said lot does not project nor encroach on adjacent streets or property, and that no adjacent walls or buildings project or encroach on said lot, and that no utility lines cross this lot except as may be shown hereon.

MAY 14 1980

33218

NOTE: This property is not located within a flood hazard area.

Survey by: Richard D. Wooten, Jr.
Greenville, South Carolina

7-2-89

S. C. R. L. S. No. 4678

GCTO ---- 3 MY 80

3 OCCT