
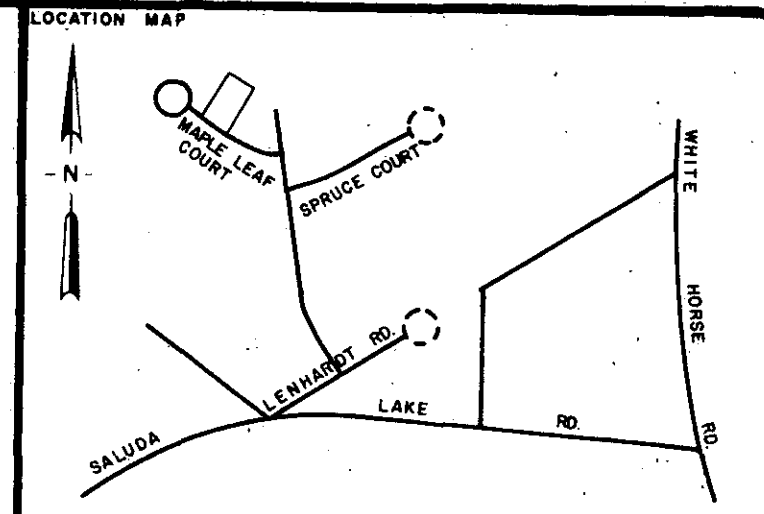
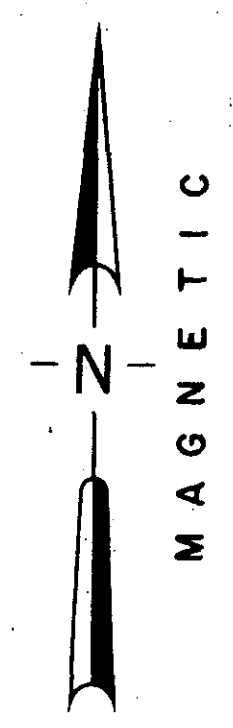


FILED
GREENVILLE CO. S. C.
MAY 20 10 15 AM '80
DONNIE S. TANKERSLEY
R.M.C.

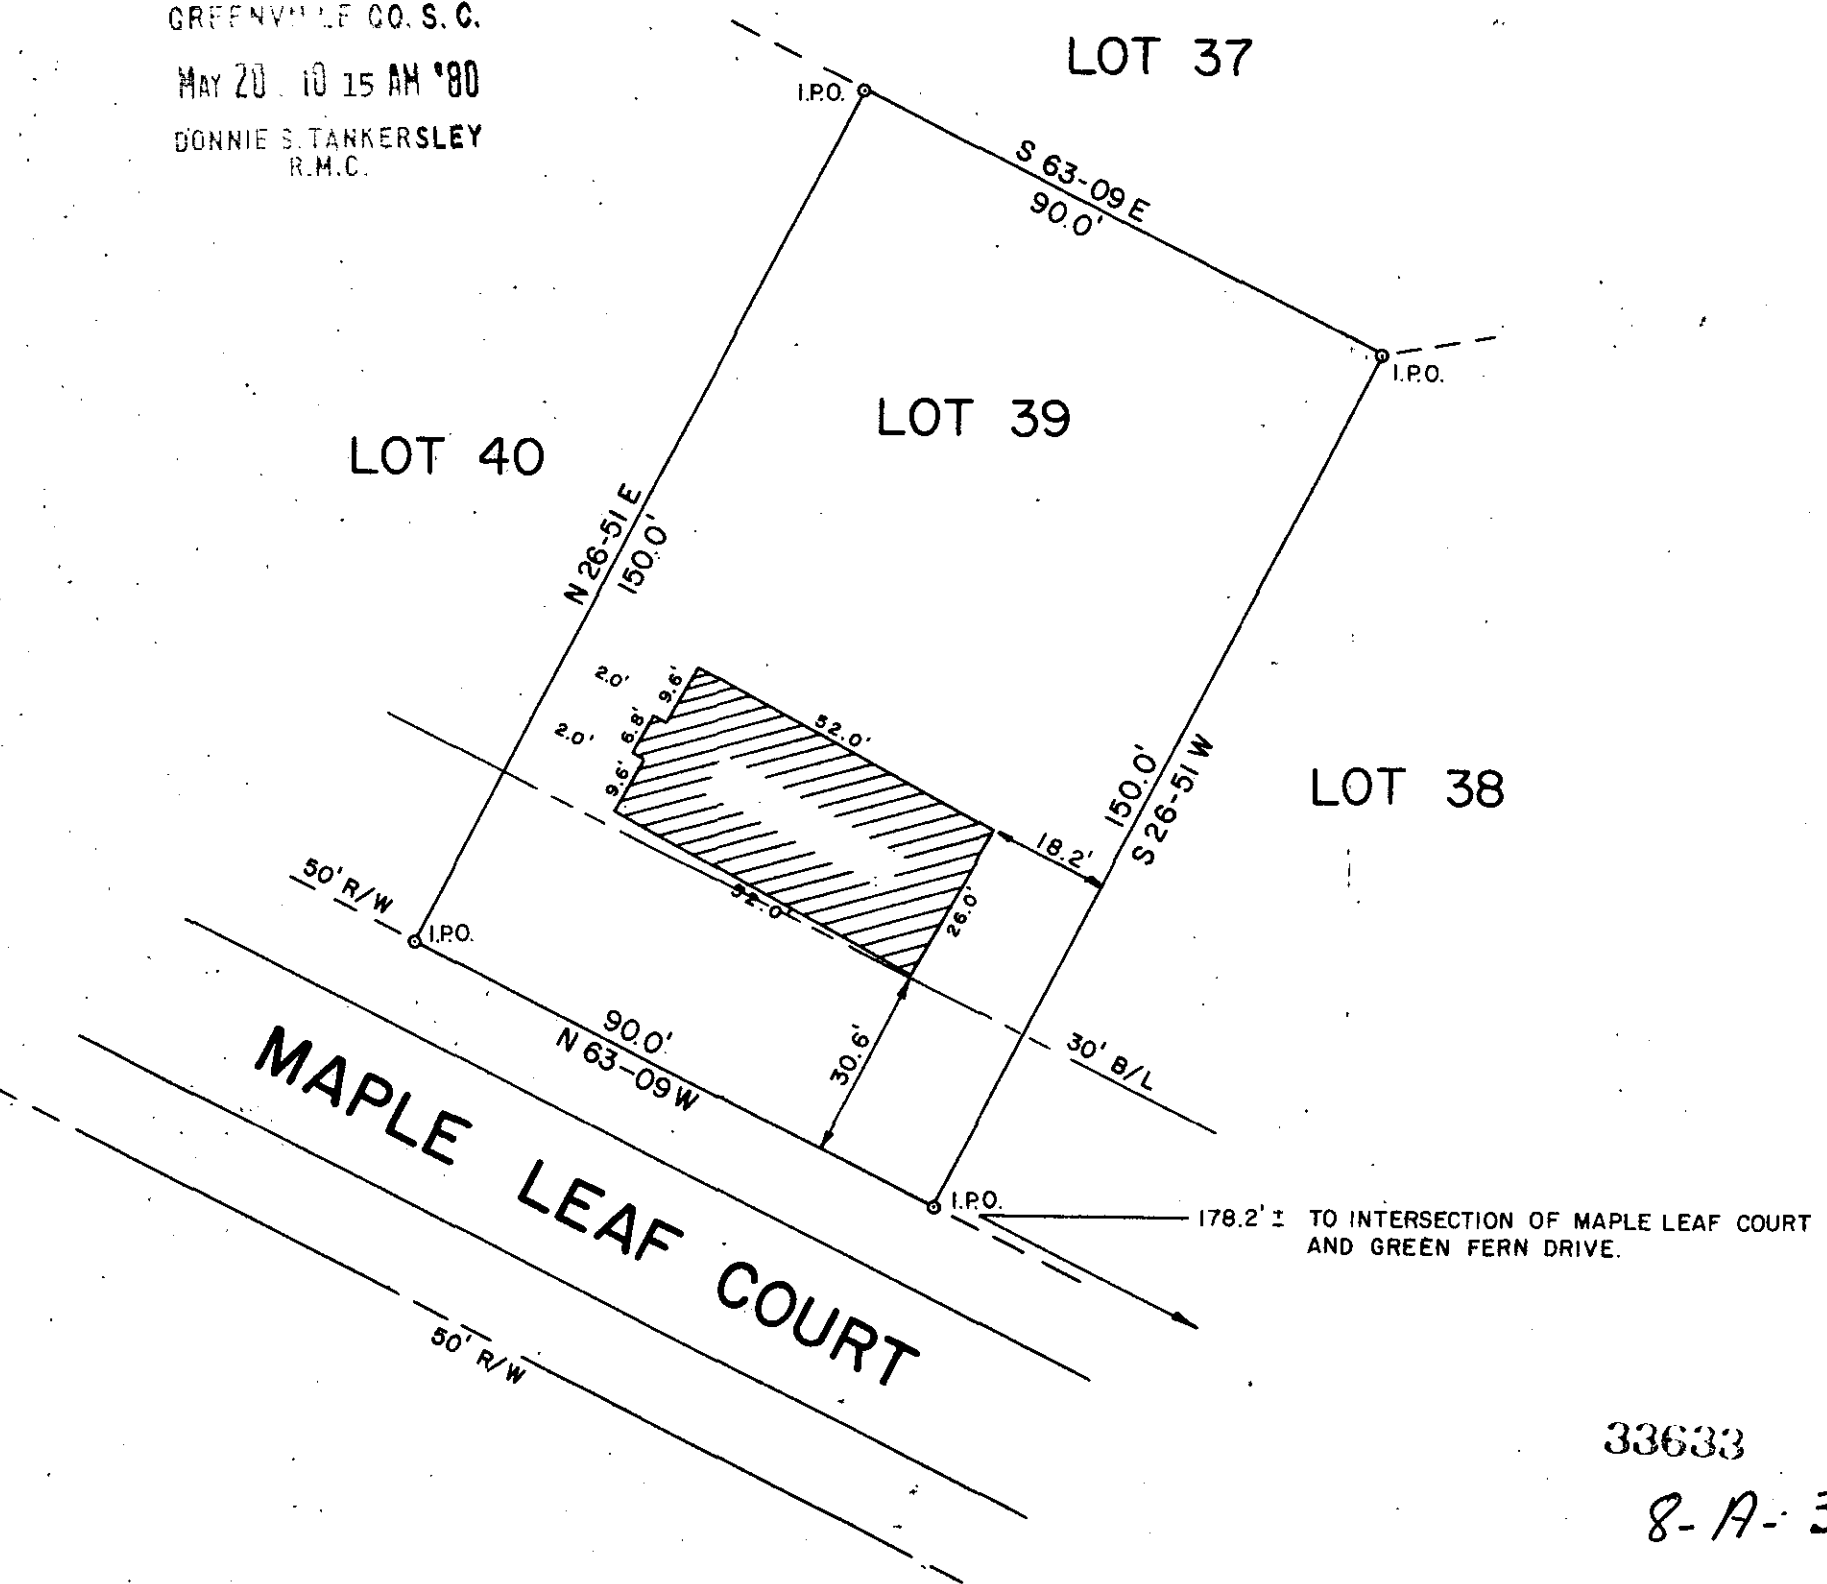

CERTIFICATION

1. (✓) This is to certify that the bearings and distances, and or measurements, shown on this plat are correct, and that all rights of way, easements, and encroachments, obvious and apparent from field observation of the subject property at the time of the survey are as shown.

2. () This is to certify that the area of the subject property shown on this plat was computed by the coordinate method of area calculation and that this is a CLASS _____ survey.

3. (✓) The Department of Housing and Urban Development Flood Way Data for Greenville County shows this property () to be in a flood plain, (✓) not to be in a flood plain. () location cannot be determined.

William W. Harbor
7261 REG. NUMBER SIGNATURE DATE

REFERENCES

PB	DB	JOB NO.
PB	DB	JOB NO.
PB	DB	JOB NO.
PB	DB	JOB NO.

PROPERTY SURVEY FOR
BOBBY JOE JONES
BUILDERS, INC.
LOT 39
WHITE OAK HILLS SUBDIVISION
GREENVILLE SOUTH CAROLINA

GRAPHIC SCALE 0 30 60
1" = 30'

RESEARCH	DRAWN	CHECK	DATE	SCALE
	STH	WNS	19 MAY 80	1" = 30'
FILE	FIELD WORK BY	JOB NO.		
		80001-61		

HARBOR ENGINEERING
P.O. BOX 263, GREENVILLE, S.C.
LANDSCAPE ARCHITECTS ENGINEERS LAND SURVEYORS

NOTE: BOUNDARY INFORMATION FOR THIS SURVEY SUPPLIED BY OWNER. AS OF DATE OF THIS SURVEY THERE IS NO PLAT OF RECORD ON FILE AT THE GREENVILLE COUNTY COURT HOUSE.

33633 MAY 20 1980
8-A-3 ✓

NOTE: THERE IS A 5' DRAINAGE AND UTILITY EASEMENT ALONG ALL SIDE AND REAR LOT LINES.

SCTO 1 MY20 80 809 5.00CI

MICROFILMED