


MICROFILMED

NORTH MAIN STREET
LAURENS ROAD
WATER & SEWER IN ST. RL.
OLD U.S. 216


S63-45E

FILED
GREENVILLE
MAY 27 4 06 PM '80
DONNIE S. TANKERSLEY
R.M.C.

GAULT STREET

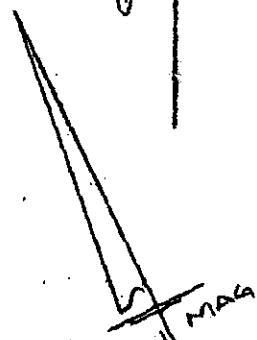

Note:
Improvements on
this lot are not
in a flood hazard area.

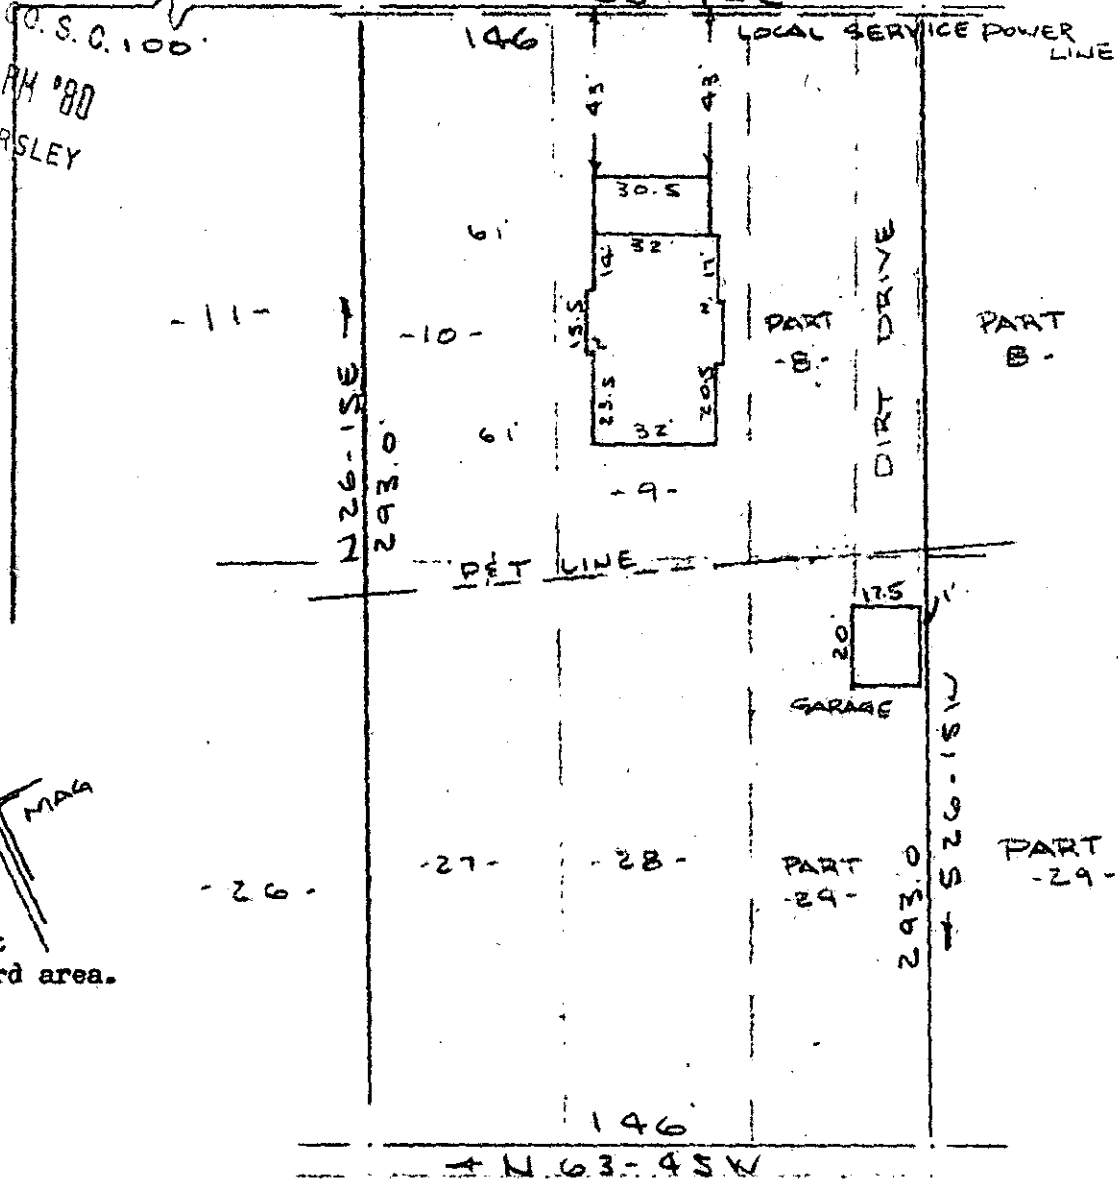

GCTO
-- 1 MY1580

GIVENS STREET
WATER & SEWER IN ST. RL.

PROPERTY OF
JOE M. YOUNTS 34248
FOUNTAIN INN, S.C.
SCALE: 1" = 50'
APRIL 1980

This is to certify that on the 1st day of April, 1980, I surveyed the property shown on this plat, being known as lots 9, 10, 27, 28 and part of lot 8 and part of lot 29 on plat of J. W. GIVENS PROPERTY and recorded in the REC Office Greenville County, S. C., in Plat Book " E " at Pages 280 & 281; and that the property lines, walls and buildings are as shown hereon, and that the walls and buildings located on said lot do not encroach or project on adjacent street or property, and that no adjacent walls or buildings encroach or project on said premises, and no power lines cross this property except as shown hereon.

MAY 27 1980

8-B-20

R. B. Bruce

CAROLINA SURVEYING CO. R. B. Bruce, RLS #1952
112 Manly St., Greenville, S. C.

3.0001