



FILED
GREENVILLE CO. S. C.

MAY 28 9 12 AM '80

DONNIE S. TANKERSLEY
R.M.C.


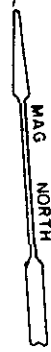


MICROFILMED

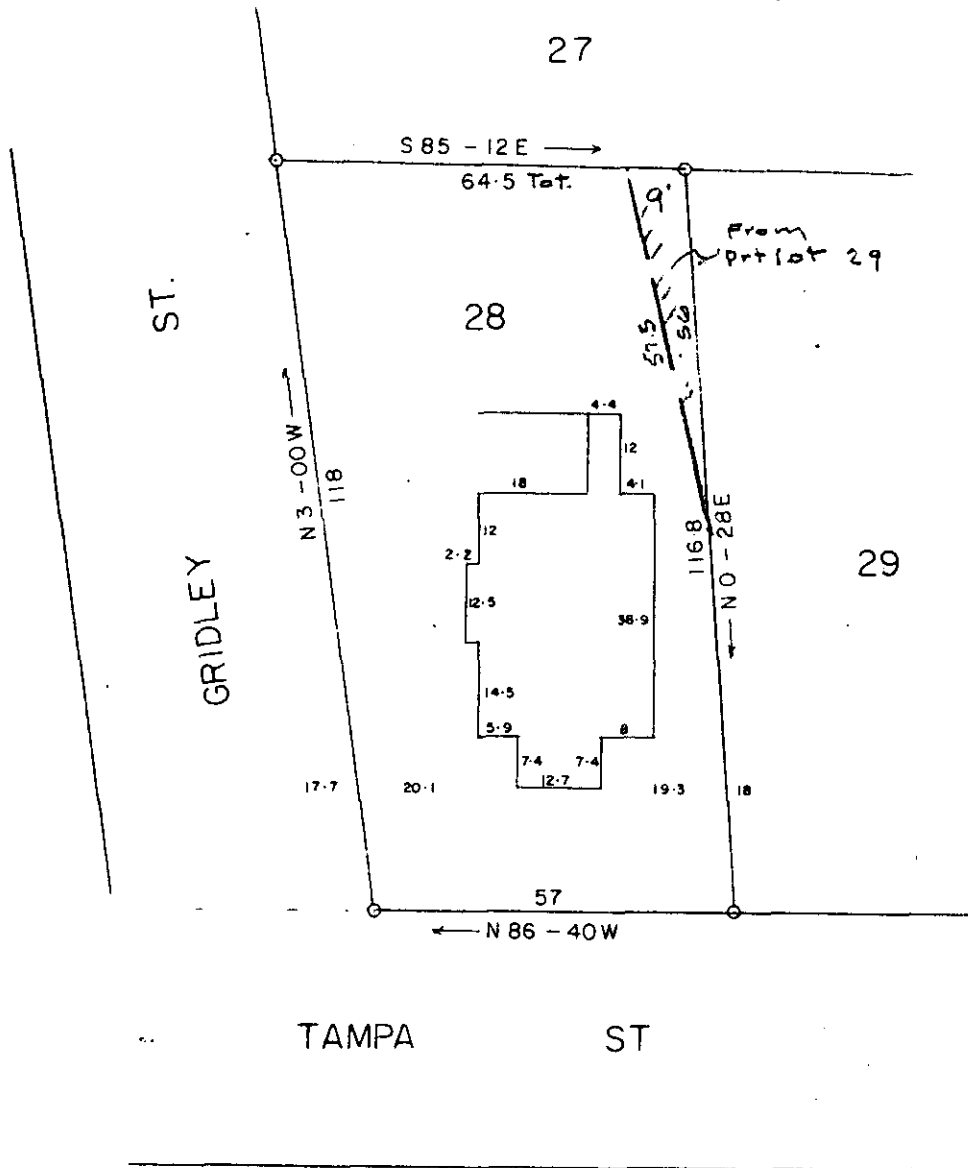

34262

MAY 28 1980

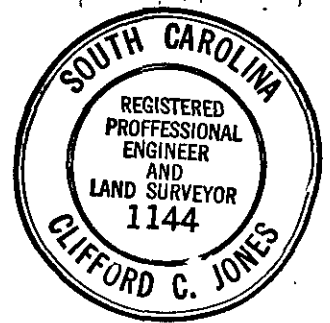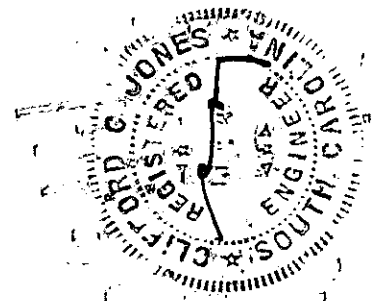

THIS LOT DOES NOT LIE IN A FLOOD PLANE

This is to certify that on the 19 day of MAY 1980, I surveyed the property shown on this plat, being LOT 28 Mountain View Land Co., recorded in Plat Book A 396 - 397 of the R.M.C. Office for Greenville County, S. C., and that the property lines, walls and buildings are as shown hereon; that the buildings located on said lot do not encroach or project on adjacent streets or property; and that no adjacent buildings or walls encroach or project on said premises, and that no utility lines cross this property.

PROPERTY OF

WILLIAM A. DICKSON 3RD

GREENVILLE COUNTY, S. C.

SCALE 1"=30' MAY-19-80

8-B-22

Eng. Engineer No. 1144 S.C.

GCTO -----3 MAY 28 80

106
35
091