


AF 10505

FILED  
 GREENVILLE CO. S.C.  
 JUN 16 3 53 PM '80  
 DONNIE S. TANKERSLEY  
 R.M.C.

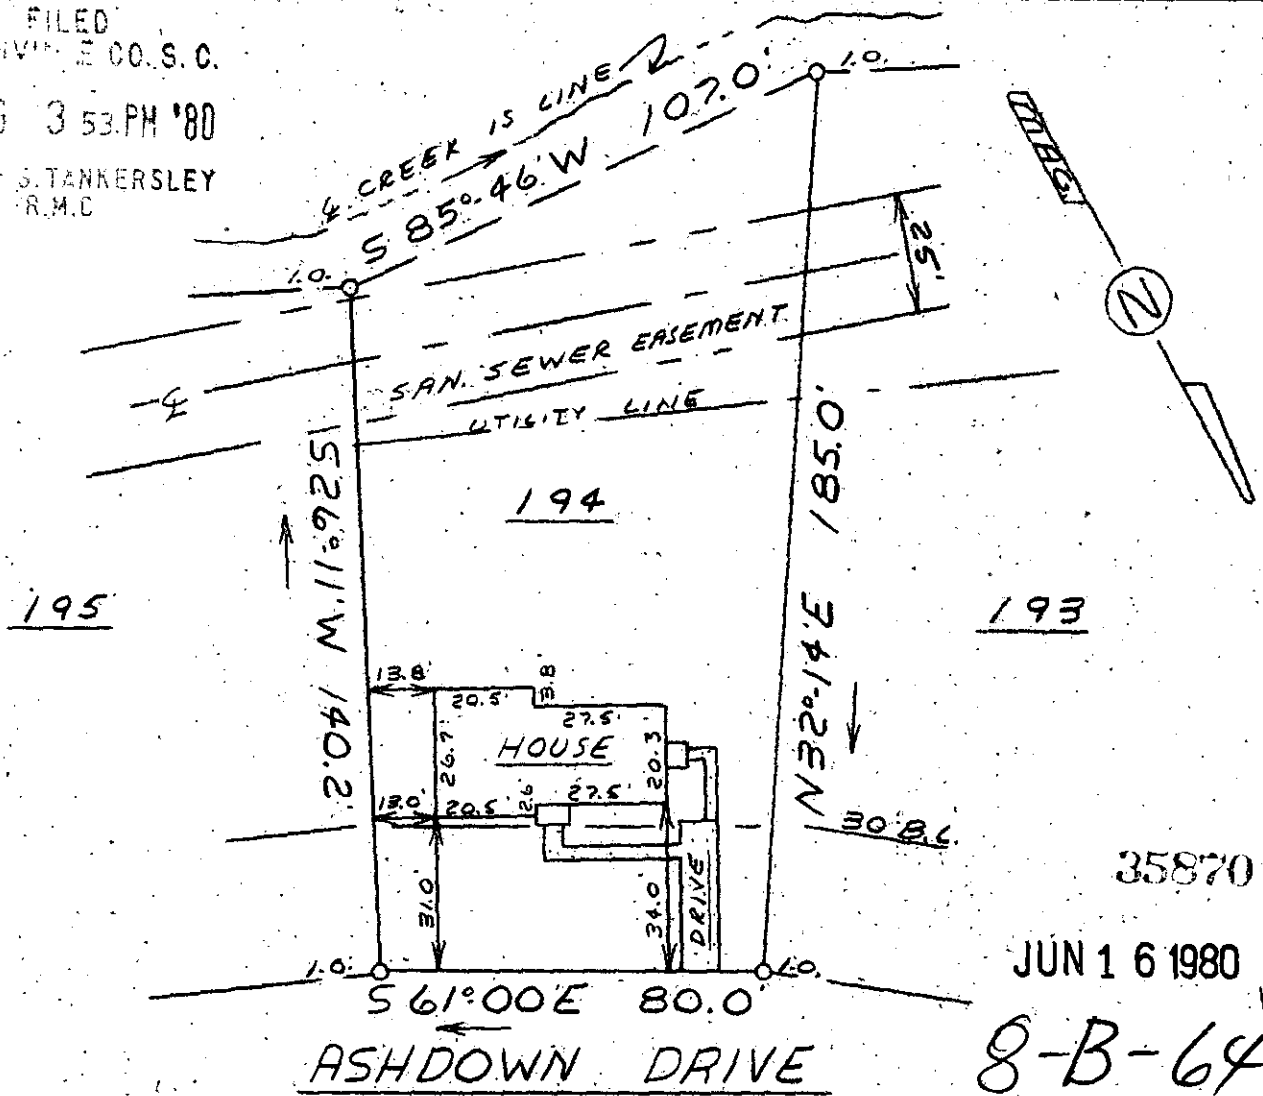

35870

JUN 16 1980

8-B-64

This is to certify that on June 11, 1980, I surveyed the property shown on this plat, known as Lot 194 on plat of Westwood South Sec. 1, recorded in the RMC Office of Greenville County in Plat Book 6H on page 56, and that the property lines, walls and buildings are as shown hereon; that the building located on said lot does not encroach or project on adjacent streets or property, and that no adjacent walls or buildings encroach or project on said premises, and that no utility lines cross this property except as shown hereon. This property is not located in a designated flood hazard area.

5' drainage and utility easement each side of all side and rear lot lines.

*James R. Freeland*  
 James R. Freeland RLS & PE 4781



STATE OF SOUTH CAROLINA  
 GREENVILLE COUNTY  
 WESTWOOD SOUTH  
 SEC. 1 - LOT 194  
 PROPERTY OF  
 JOHN WILLIAM DUNLAP &  
 KATHLEEN M. DUNLAP

FREELAND & ASSOCIATES  
 Engineers • Land Surveyors  
 GREENVILLE, S.C.  
 SURVEY *WBH*  
 DRAWN *MC*  
 CHECK *MC*  
 SCALE *1" = 40'*  
 DATE *6-11-80*  
 DWG. NO. *80-5140*