


FILED
GREENVILLE CO. S. C.

JUN 23 2 50 PM '80

DONNIE S. TANKERSLEY
R.M.C.

(76)

(77)

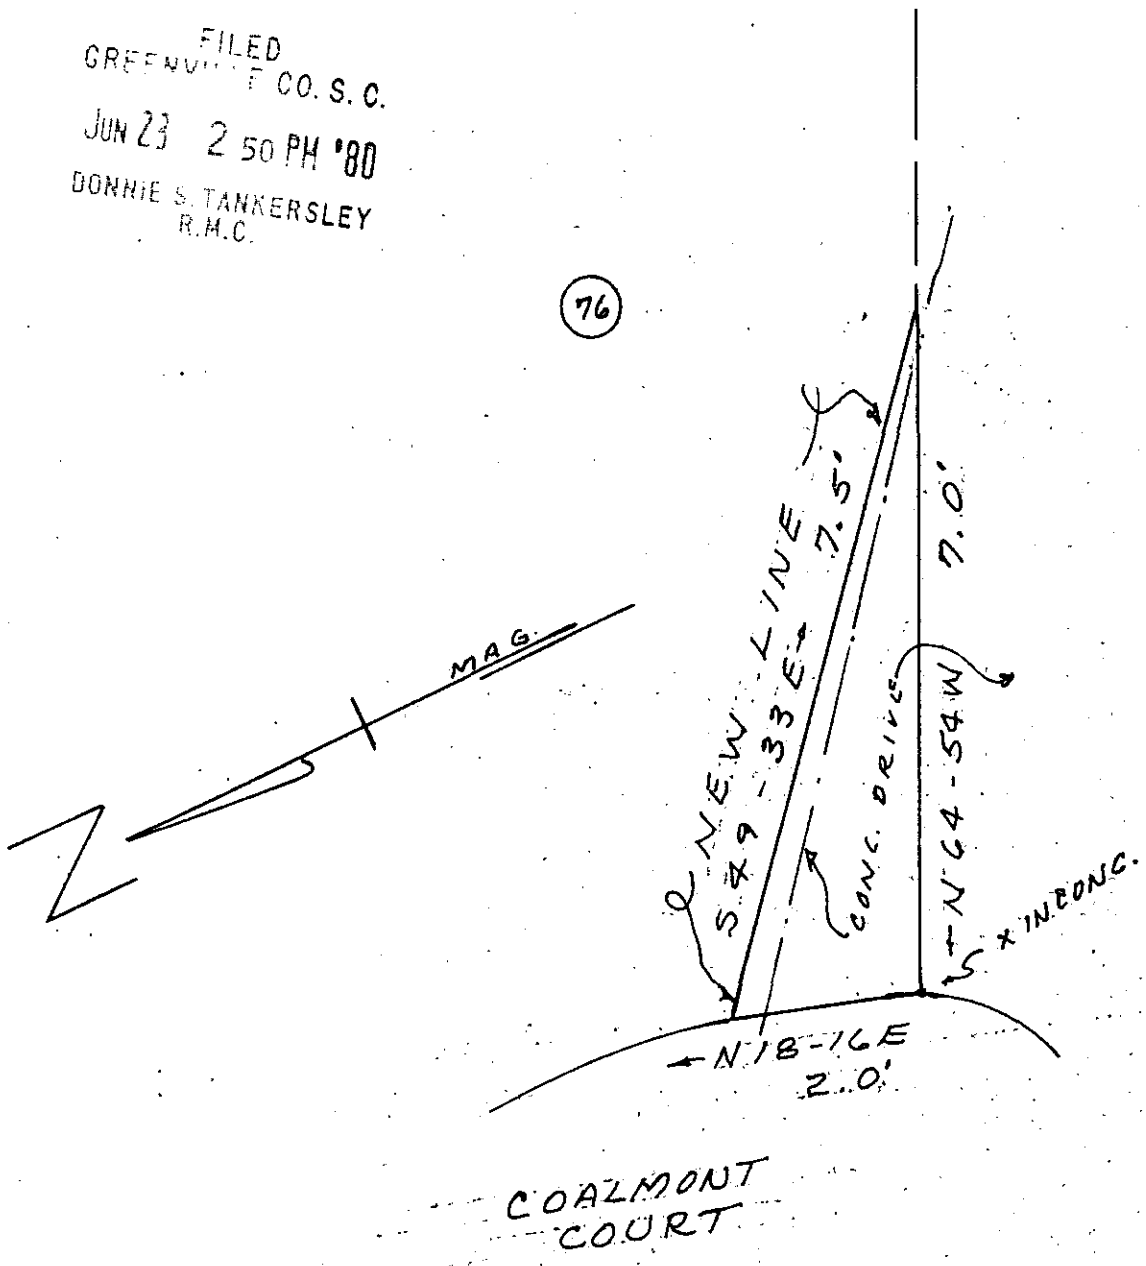

REVISION

LOT 76 - SEC IV - BELLINGHAM

SIMPSONVILLE, S.C.

JUN 23 1980

JUNE 4, 1980

SCALE 1" = 2'

8-B-79

SURVEY BY: CLARKSON SURVEYING

D. C. Clarkson, Jr.

36457

S.C.R.L.S. No. 2589

JUN 23 80 405

3.00CI