

This is to certify that on June 26, 1980, I surveyed the property shown on this plat, known as Lot 156 on plat of Hillsborough Sec. 3, recorded in the RMC Office of Greenville County in Plat Book 4R on page 42, and that the property lines, walls and buildings are as shown hereon; that the building located on said lot does not encroach or project on adjacent streets or property, and that no adjacent walls or buildings encroach or project on said premises, and that no utility lines cross this property except as shown hereon. This property is not located in a designated flood hazard area.


122

James R. Freeland
 James R. Freeland RLS & PE 4781

JUL 1 1980

8-C-7

M 4.5-1-154

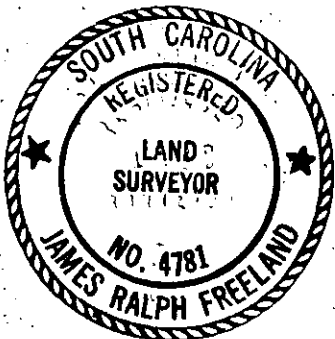

SEAL

STATE OF SOUTH CAROLINA
 GREENVILLE COUNTY

HILLSBOROUGH
 SEC. 3 - LOT 156

PROPERTY OF
 JOHN C. EICHELBERGER
 EUNICE E. EICHELBERGER

FREELAND & ASSOCIATES
 Engineers • Land Surveyors

GREENVILLE, S.C.

SURVEY D.C.H.
 DRAWN M.C.
 CHECK M.C.
 SCALE 1" = 40'
 DATE 6-26-80
 DWG. NO. 5213