AF 10505

MICROFILMED

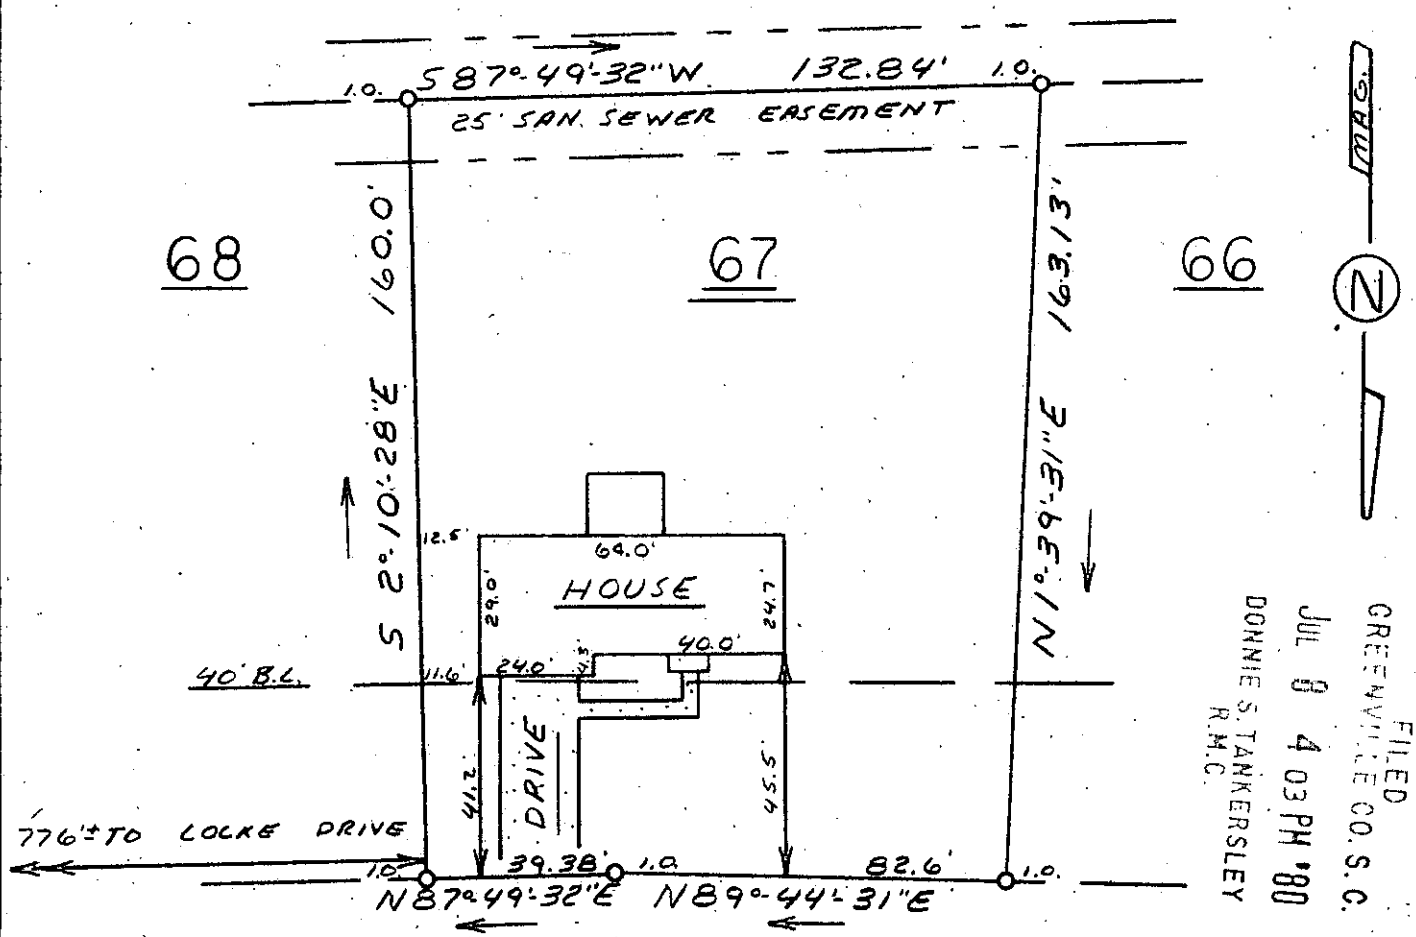

FILED
GREENVILLE CO. S.C.
JUL 8 4 03 PM '80
DONNIE S. TANKERSLEY
R.M.C.

This is to certify that on June 26, 1980, I surveyed the property shown on this plat, known as Lot 67 on plat of Knollwood Heights Map 1 Sec. 5, recorded in the RMC Office of Greenville County in Plat Book 4R on page 91, and that the property lines, walls and buildings are as shown hereon; that the building located on said lot does not encroach or project on adjacent streets or property, and that no adjacent walls or buildings encroach or project on said premises, and that no utility lines cross this property except as shown hereon. This property is not located in a designated flood hazard area.

There is a 5' drainage and utility easement each side of all side and rear lot lines.

James R. Freeland

James R. Freeland RLS & PE 4781

583

8-C-20

JUL 8 1980

m 8.2-1-76

SOUTH CAROLINA REGISTERED LAND SURVEYOR NO. 4781 JAMES RALPH FREELAND

SEAL

STATE OF SOUTH CAROLINA
GREENVILLE COUNTY

KNOLLWOOD HEIGHTS
SEC. 5 – LOT 67
PROPERTY OF
ALAN A. SOCHA
&
NANCY SOCHA

FREELAND & ASSOCIATES
Engineers • Land Surveyors
GREENVILLE, S.C.

SURVEY	DCH
DRAWN	M.C.
CHECK	MC
SCALE	1" = 40'
DATE	6-26-80
DWG. NO.	80-5209

4466