
- GRACELAND

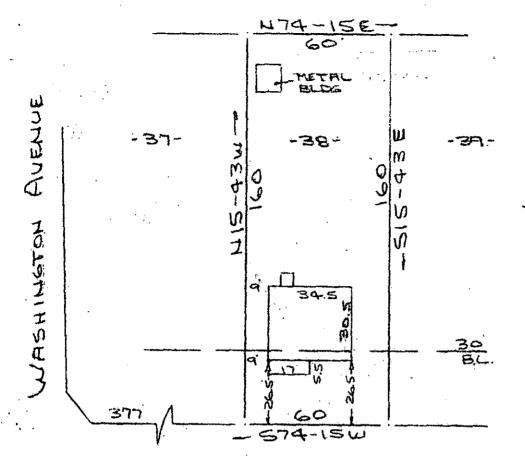

Note: Improvements on this lot are not in a flood hazard area.

CRESTMORE DRIVE WATER & SEWER IN ST RIW

TIM

PROPERTY OF

CAROL T. HENDRIX BOWMAN NEAR GREENVILLE, S.C. SCALE: 1"=40" 9 JULY 1980

SCALE: 1"=40 9 3004 1980

This is to certify that on the 9th day of July, 1980, I surveyed the property shown on this plat, being known as lot 38 on plat of GRAND VIEW and recorded in the RMC Office Greenville County, 3. C., in Plat Book " KE " at Page 93; and that the property lines, walls and buildings are as shown hereon, and that the walls and buildings located on said lot do not encroach or project on adjacent street or O property, and that no adjacent walls or buildings encrosed or project on said premises, and no power lines cross this property except as shown beream.

JUL 1 0 1990

SURVEYING go.

CAROLINA 112

229-1-100

Manly St., Greenville, G.