


FILED  
GREENVILLE CO. S.C.  
JUL 25 4 44 PM '80  
DONNIE S. TANKERSLEY  
R.M.C.

This is to certify that on July 22, 1980, I surveyed the property shown on this plat, known as Lot 88 on plat of Vista Hills, recorded in the RMC Office of Greenville County in Plat Book P on page 149, and that the property lines, walls and buildings are as shown hereon; that the building located on said lot does not encroach or project on adjacent streets or property, and that no adjacent walls or buildings encroach or project on said premises, and that no utility lines cross this property except as shown hereon. This property is not located in a designated flood hazard area.

2383  
James R. Freeland  
James R. Freeland RLS & PE 4781  
8-C-67

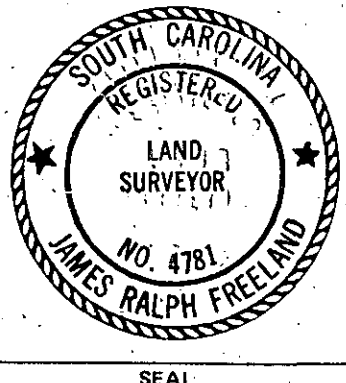

STATE OF SOUTH CAROLINA  
GREENVILLE COUNTY  
VISTA HILLS  
LOT 88  
PROPERTY OF  
JOSEPH THOMAS M'NUTT  
NANCY K. M'NUTT

FREELAND & ASSOCIATES  
Engineers • Land Surveyors  
GREENVILLE, S.C.  
SURVEY FL  
DRAWN JRF  
CHECK RP  
SCALE 1" = 40'  
DATE 7-22-80  
DWG. NO. 80-5300