AF 10505

MICROFILMED

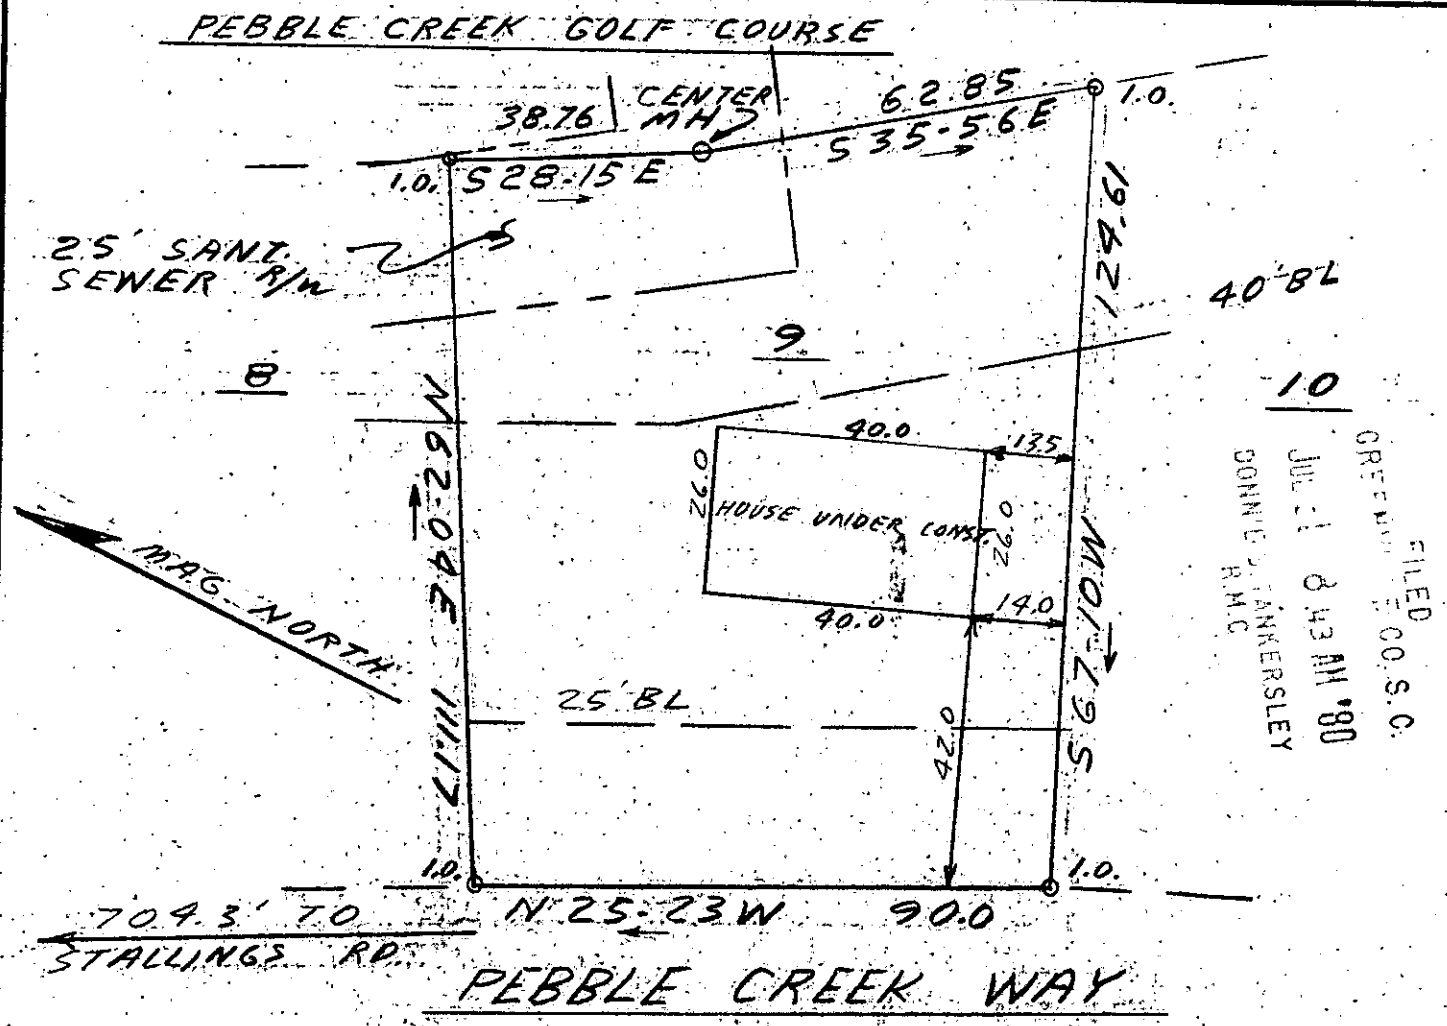

FILED
GREENVILLE CO. S.C.
JUL 31 8 43 AM '80
CONNIE P. TANKERSLEY
R.M.C.

This is to certify that on July 29, 1980, I surveyed the property shown on this plat, known as Lot 9 on plat of Pebblecreek Phase IV Sec. II, recorded in the RMC Office of Greenville County in Plat Book 7C on page 47, and that the property lines, walls and buildings are as shown hereon; that the building located on said lot does not encroach or project on adjacent streets or property, and that no adjacent walls or buildings encroach or project on said premises, and that no utility lines cross this property except as shown hereon. This property is not located in a designated flood hazard area.

5' drainage and utility easement along each side of all side and rear lot lines.

2816

James R. Freeland

James R. Freeland RLS & PE 4781

8-C-78

JUL 31 1980

SOUTH CAROLINA REGISTERED LAND SURVEYOR NO. 4781 JAMES RALPH FREELAND

SEAL

STATE OF SOUTH CAROLINA
GREENVILLE COUNTY

PEBBLECREEK - PHASE IV
SECT. II - LOT 9
PROPERTY OF
TIMOTHY M. DORGAN
ELIZABETH M. DORGAN

FREELAND & ASSOCIATES
Engineers • Land Surveyors
GREENVILLE, S.C.

SURVEY	L.T.
DRAWN	J.R.F.
CHECK	M.C.
SCALE	1" = 30'
DATE	7-29-80
DWG. NO.	80-5346

GCTO ------ 2 JL31 80 612