

GREENVILLE CO. S.C.
 AUG 4 10 18 AM '80
 DONNIE STANKERSLEY
 R.M.C.

AUG 4 1980

✓ P.C-92 3314


THIS IS TO CERTIFY THAT ON THIS DATE I SURVEYED THE PROPERTY SHOWN HEREON AND THE LINES ARE AS SHOWN, THAT THE BUILDING(S) OR WALL(S) DO NOT ENCROACH ON THE ADJOINING PROPERTY, AND THAT THE BUILDING(S) OR WALL(S) OF THE ADJACENT PROPERTY DO NOT ENCROACH ON THIS PROPERTY EXCEPT AS SHOWN. I CERTIFY THAT THIS PROPERTY (IS NOT) IN ANY FLOOD AREA.

REF. PLAT BOOK 4 P. 03.
 REF. DEED BOOK PP.

SURVEY FOR
**CHARLES E. and
 GERALDINE M. TRINKLE**
 LOCATED APPROX. 4 MILES NORTHWEST OF GREENVILLE - BUXTON
 SUBD. SHEET TWO

COUNTY: GREENVILLE	COUNTY BLOCK MAP 445.02-1-3	STATE: SOUTH CAROLINA
DATE: JULY 28, 1980	FIELD CHIEF: B. E. HUSKEY	DRAWN BY: L. B. MORROW
REVISED:		

SCALE 1" = 40'

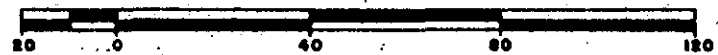

WOLFE & HUSKEY, INC. ENGINEERING and SURVEYING
 P. O. BOX 35 · LYMAN, S. C. 29365

