


FILED
GREENVILLE CO. S. C.

AUG 7 1980

904
DONNELL TANKERSLEY
R.M.C.

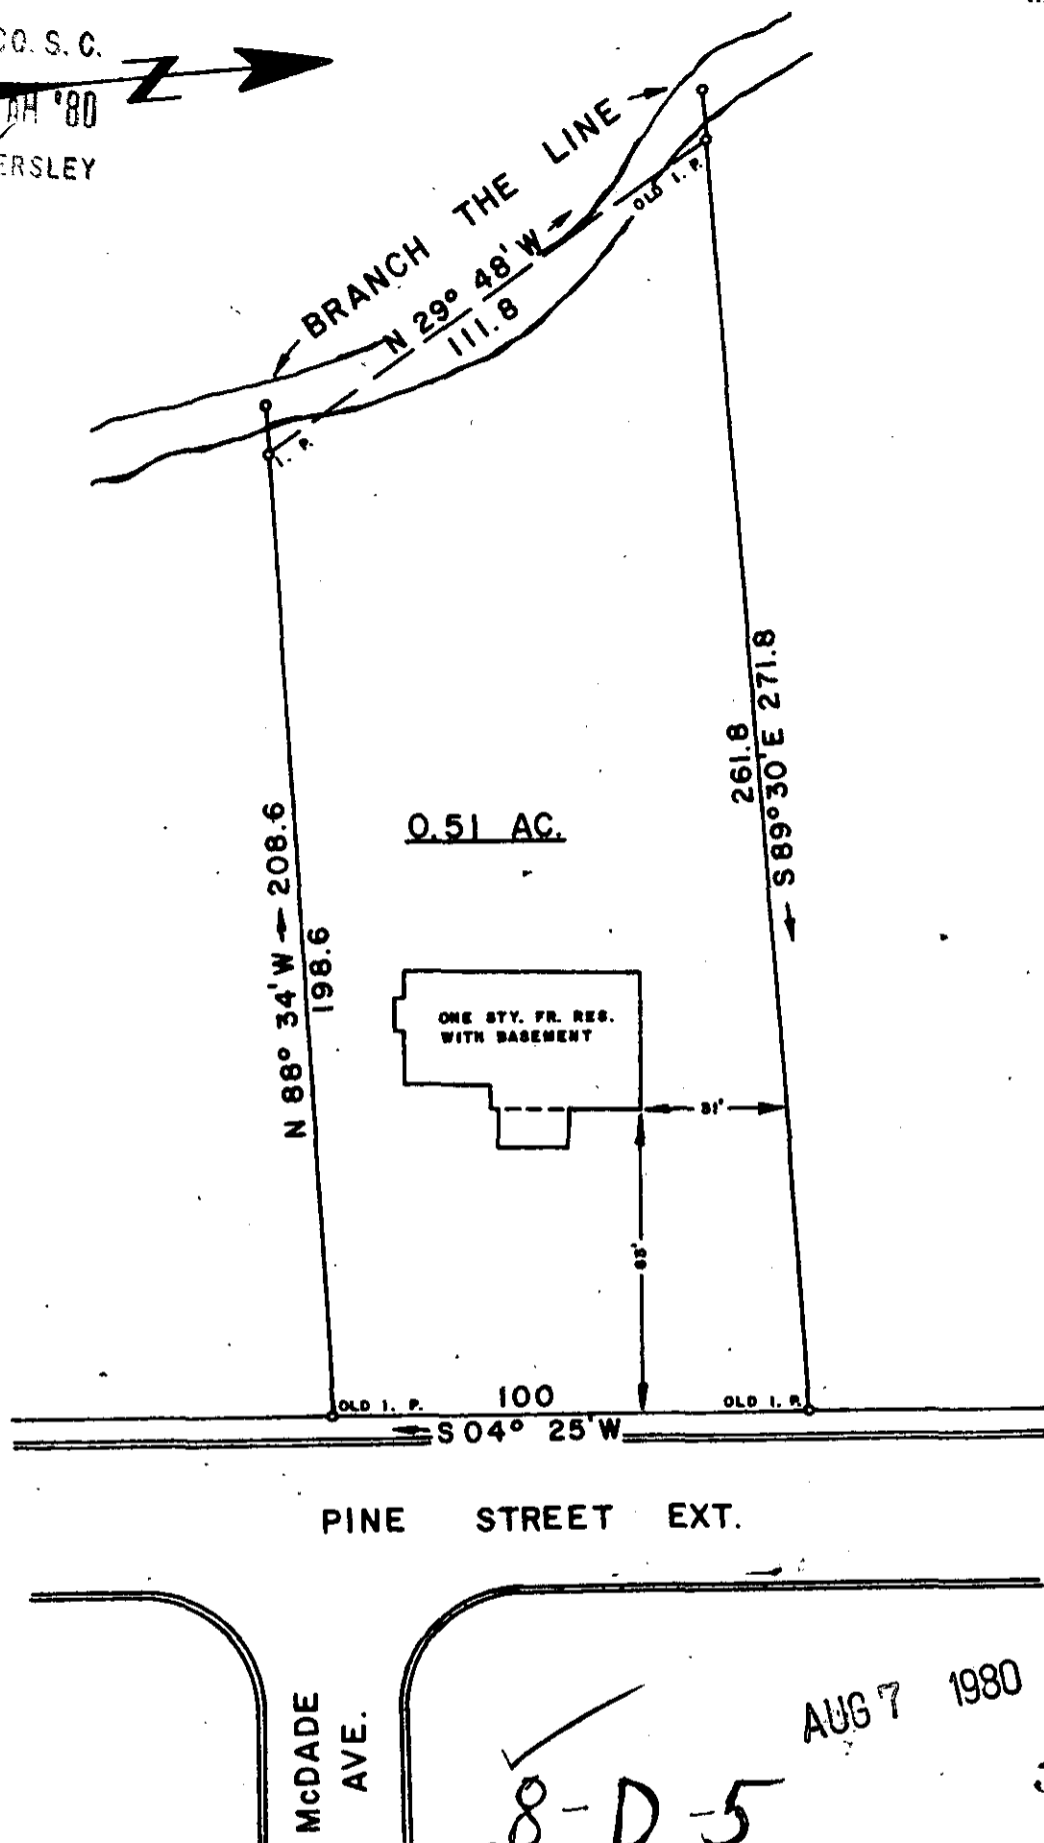

AUG 7 1980

8-D-5

3627

THIS IS TO CERTIFY THAT ON THIS DATE I-SURVEYED THE PROPERTY SHOWN HEREON AND THE LINES ARE AS SHOWN, THAT THE BUILDING(S) OR WALL(S) DO NOT ENCR OACH ON THE ADJOINING PROPERTY, AND THAT THE BUILDING(S) OR WALL(S) OF THE ADJACENT PROPERTY DO NOT ENCR OACH ON THIS PROPERTY EXCEPT AS SHOWN. I CERTIFY THAT THIS PROPERTY ~~IS~~ IS NOT IN ANY FLOOD AREA.

REF. PLAT BOOKS 688, PP. 388.
REF. DEED BOOK PP.

SURVEY FOR

J. P. McGUIRE

LOCATED AT GREER

COUNTY: GREENVILLE	COUNTY BLOCK MAP G 17 - 1 parcel 8	STATE: SOUTH CAROLINA
------------------------------	---------------------------------------	---------------------------------

DATE: JULY 24, 1980	FIELD CHIEF: G. A. WOLFE	DRAWN BY: L. B. MORROW
---------------------	-----------------------------	---------------------------

SCALE 1" = 40'

WOLFE & HUSKEY, INC. ENGINEERING and SURVEYING
P. O. BOX 35, LYMAN, S. C. 29365

