

MICROFILMED

FILED
GREENVILLE CO. S. C.
AUG 15 12 46 PM '80

DONNIE S. TANKERSLEY
R.M.C.

U.S. HWY. 25

TO GREENVILLE

S 28 - 32 W
105

R/W

100'

100'

MAG NORTH

S 67 - 19 E
226

65

N 69 - 29 W
186.1 / 198.1

66


64

4624

AUG 15 1980

8 D. 35

PART OF LOT 66

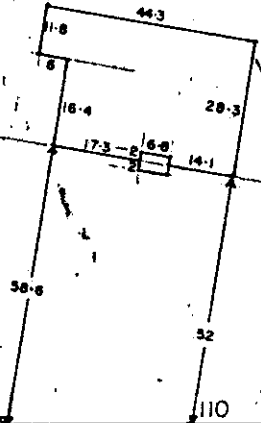

SERVICE LINE

400 TO
S.C. HWY. 253

N 15 - 07 E

HILL TOP DR.



Note: This lot does not lie in a flood plane.

PROPERTY OF

ROBERT F. VON-BRIESEN

SARAH J. VON-BRIESEN

GREENVILLE COUNTY, S. C.

This is to certify that on the 11 day of AUG,
1980, I surveyed the property shown on this
plat, being LOT 65 AND PART OF 66, RAY, E.
MC ALISTER SUB., recorded in Plat Book EE
92-93 of the R.M.C. Office for Greenville County,
S. C., and that the property lines, walls and
buildings are as shown hereon; that the buildings
located on said lot do not encroach or project on
adjacent streets or property; and that no adjacent
buildings or walls encroach or project on said
premises, and that no utility lines cross this
property.

SCALE 1"=40' AUG. - 11 - 80 3.0001

Reg. Engineer No. 1144 S.C.

2 AU 15 80 1127