MICROFILMED

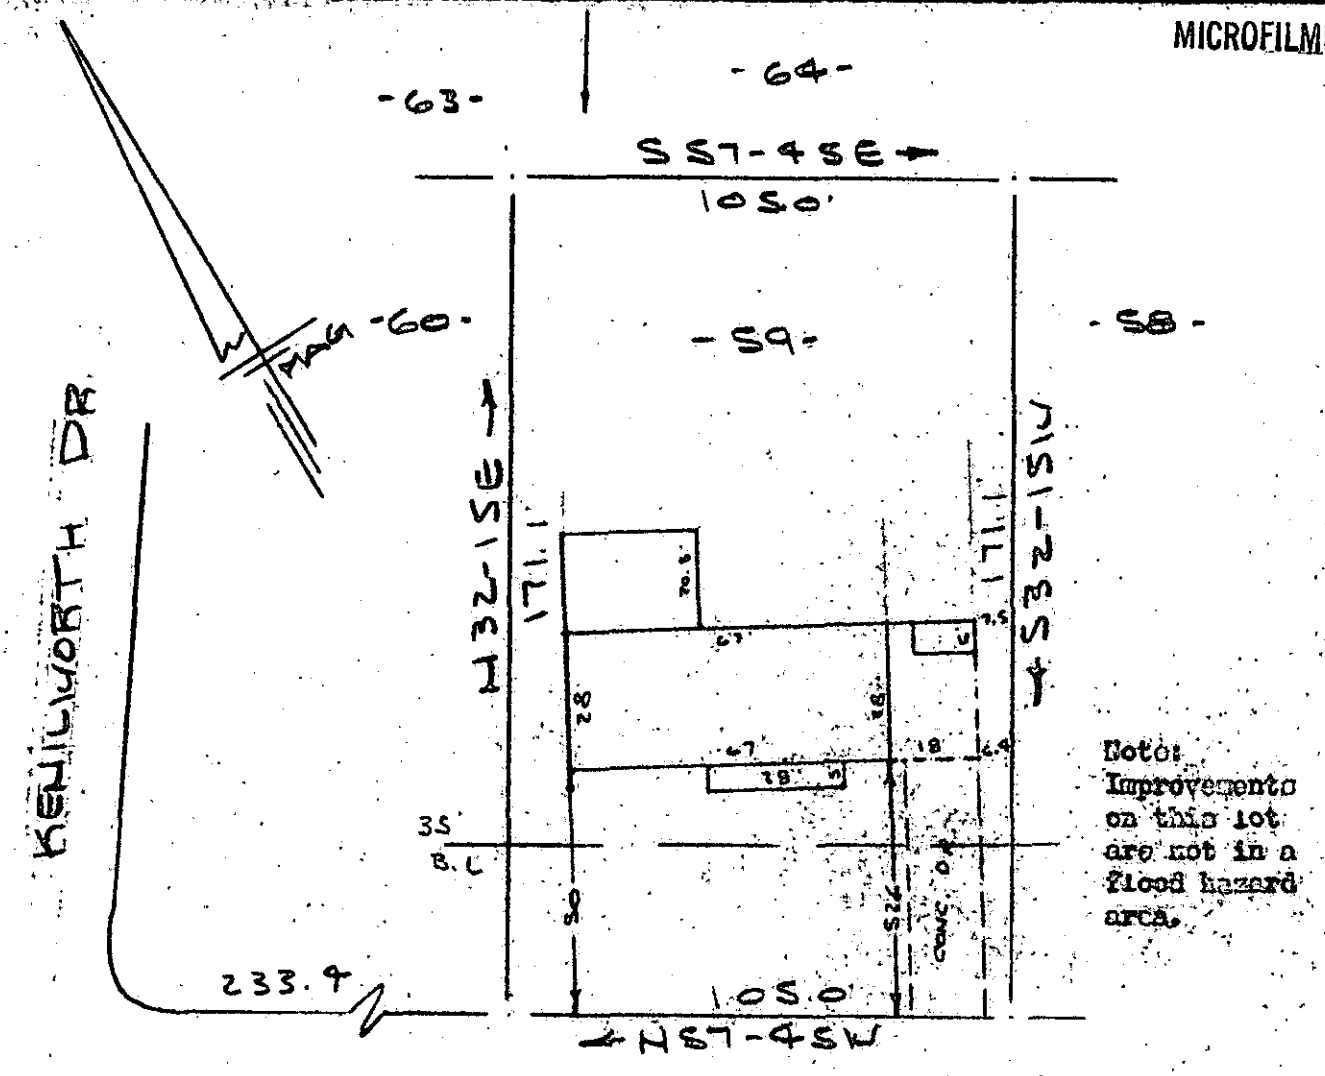

Note: Improvements on this lot are not in a flood hazard area.

NEW CASTLE WAY
WATER & SEWER IN ST R/W
PROPERTY OF
STEPHEN R. LANE & LAURA H. LANE
NEAR GREENVILLE, S.C.
SCALE 1" = 40' 7 AUG 1980

FILED
GREENVILLE CO. S.C.
AUG 19 10 36 AM '80
DONNIE S. TANKERSLEY
R.M.C.

This is to certify that on the 7th day of August, 1980, I surveyed the property shown on this plat, being known as lot 59 on plat of SECTION TWO & THREE WELLINGTON GREEN and recorded in the RMC Office Greenville County, S. C., in Plat Book " YY " at Page 116; and that the property lines, walls and buildings are as shown hereon, and that the walls and buildings located on said lot do not encroach or project on adjacent street or property, and that no adjacent walls or buildings encroach or project on said premises, and no power lines cross this property except as shown hereon.

R. B. Bruce

R. B. Bruce, RLS #1952

SOUTH CAROLINA REGISTERED LAND SURVEYOR R. B. BRUCE

5046

8-D-40

AUG 19 1980

CAROLINA SURVEYING CO.
112 Manly St.
Greenville, S. C.

AUG 19 1980

541.4-1-42

GUO 3 AU1980 514

3.00CI

227/84