

160' TO TRAILS  
END

KNOLLWOOD LANE

AUG 25 1980

This is to certify that on August 21, 1980, I surveyed the property shown on this plat, known as Lot 137 on plat of Cleveland Forest, recorded in the RMC Office of Greenville County in Plat Book M on pages 56 & 57, and that the property lines, walls and buildings are as shown hereon; that the building located on said lot does not encroach or project on adjacent streets or property, and that no adjacent walls or buildings encroach or project on said premises, and that no utility lines cross this property except as shown hereon. This property is not located in a designated flood hazard area.


\* AND PART LOT 93

5762

8-D-68

James R. Freeland RLS & PE 4781

67.1-4-4

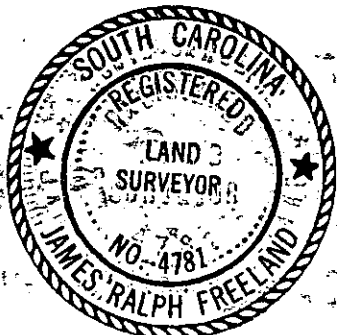

SEAL

STATE OF SOUTH CAROLINA  
GREENVILLE COUNTY

CLEVELAND FOREST  
LOT 137 & PART LOT 93

PROPERTY OF  
JOHN ALEXANDER REYNOLDS &  
ELIZABETH McGRADY REYNOLDS

FREELAND & ASSOCIATES  
Engineers • Land Surveyors

GREENVILLE, S.C.

SURVEY *WBH*  
 DRAWN *JRF*  
 CHECK *JMLC*  
 SCALE 1" = 40'  
 DATE 8-21-80  
 DWG. NO. 80-5519