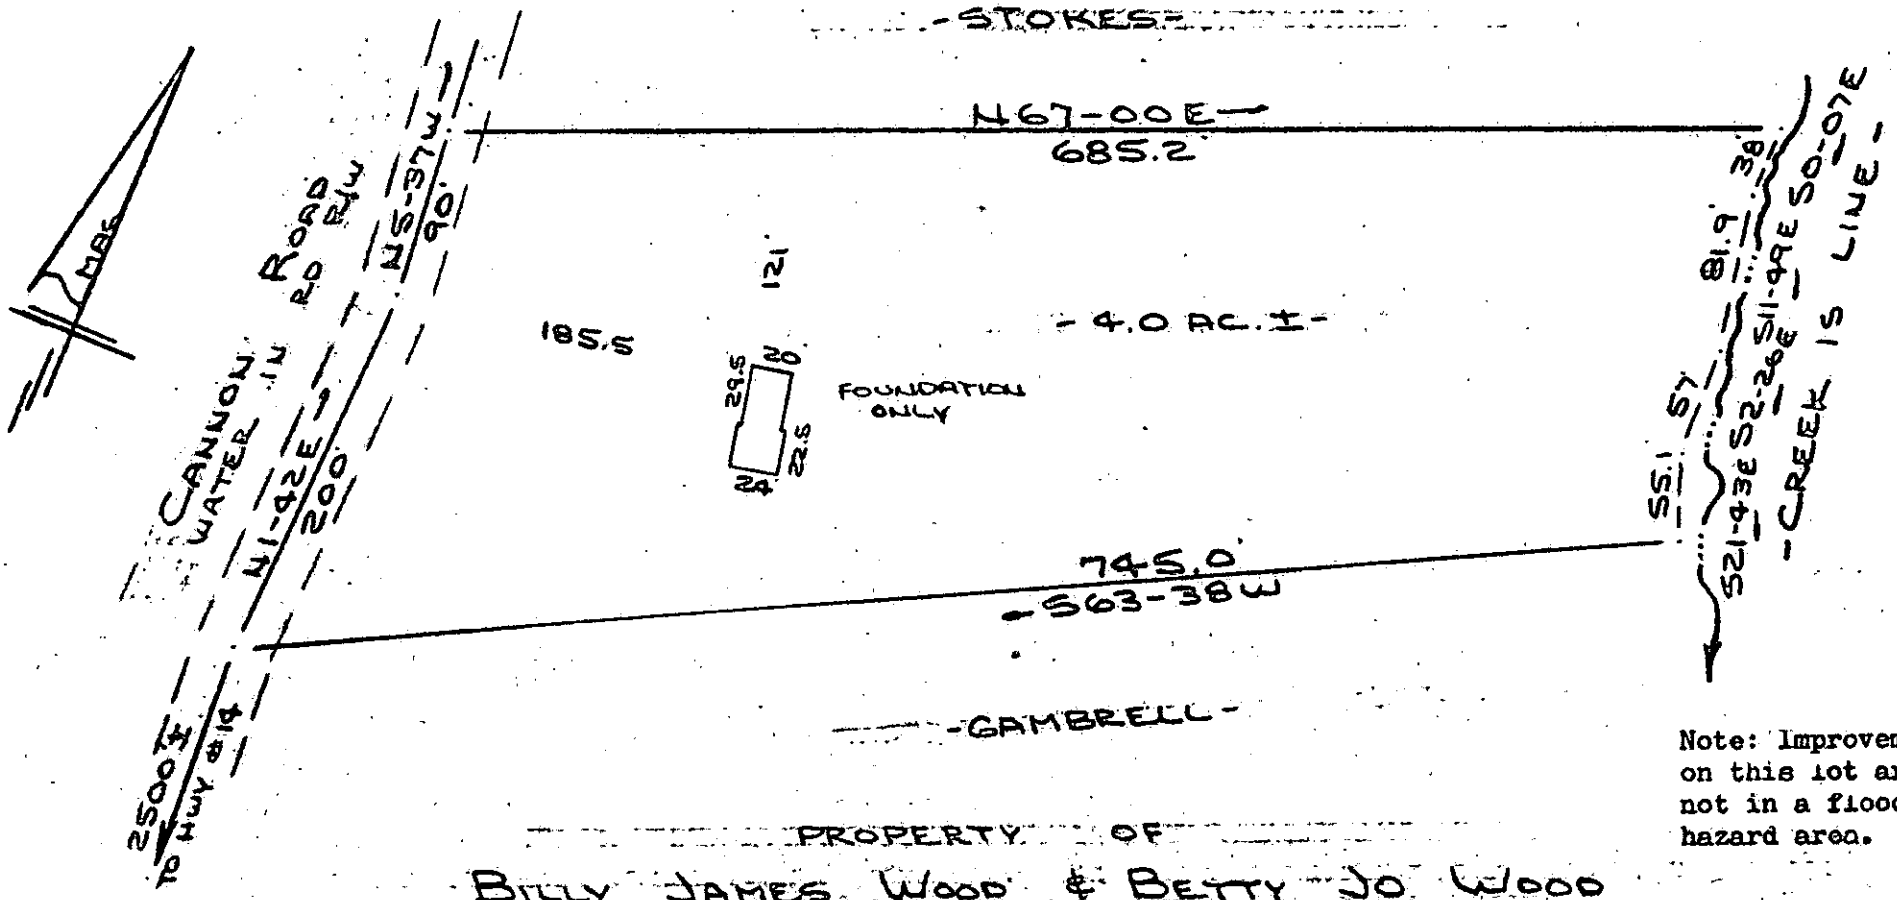

Note: Improvements on this lot are not in a flood hazard area.

PROPERTY OF

BILLY JAMES WOOD & BETTY JO WOOD

NEAR GREENVILLE, S.C.

SCALE: 1"=100' 5 SEPT. 1980

This is to certify that on the 5th day of September, 1980, I surveyed the property shown on this plat, being known as 4.0 acres on plat of BILLY JAMES WOOD & BETTY JO WOOD and recorded in the RMC Office Greenville County, S. C., in Plat Book " " at Page ; and that the property lines, walls and buildings are as shown hereon, and that the walls and buildings located on said lot do not encroach or project on adjacent street or property, and that no adjacent walls or buildings encroach or project on said premises, and no power lines cross this property except as shown hereon.

7501

8-E-30

SEP 8 1980

R. B. Bruce

R. B. Bruce, RLS #1930

CAROLINA SURVEYING CO.
112 Manly St.
Greenville, S. C.

3 1 38 TP 8E

FILED
GREENVILLE CO. S. C.
SEP 8 8 28 AM '80
DONNIE S. TANKERSLEY
R.M.C.

300 A4

MICROFILMED

228/55

631.6-1-13.6 & 13.7