


MICROFILMED

FILED
GREENVILLE CO. S. C.

SEP 12 10 48 AM '80

DONNIE S. TANKERSLEY
R.M.C.

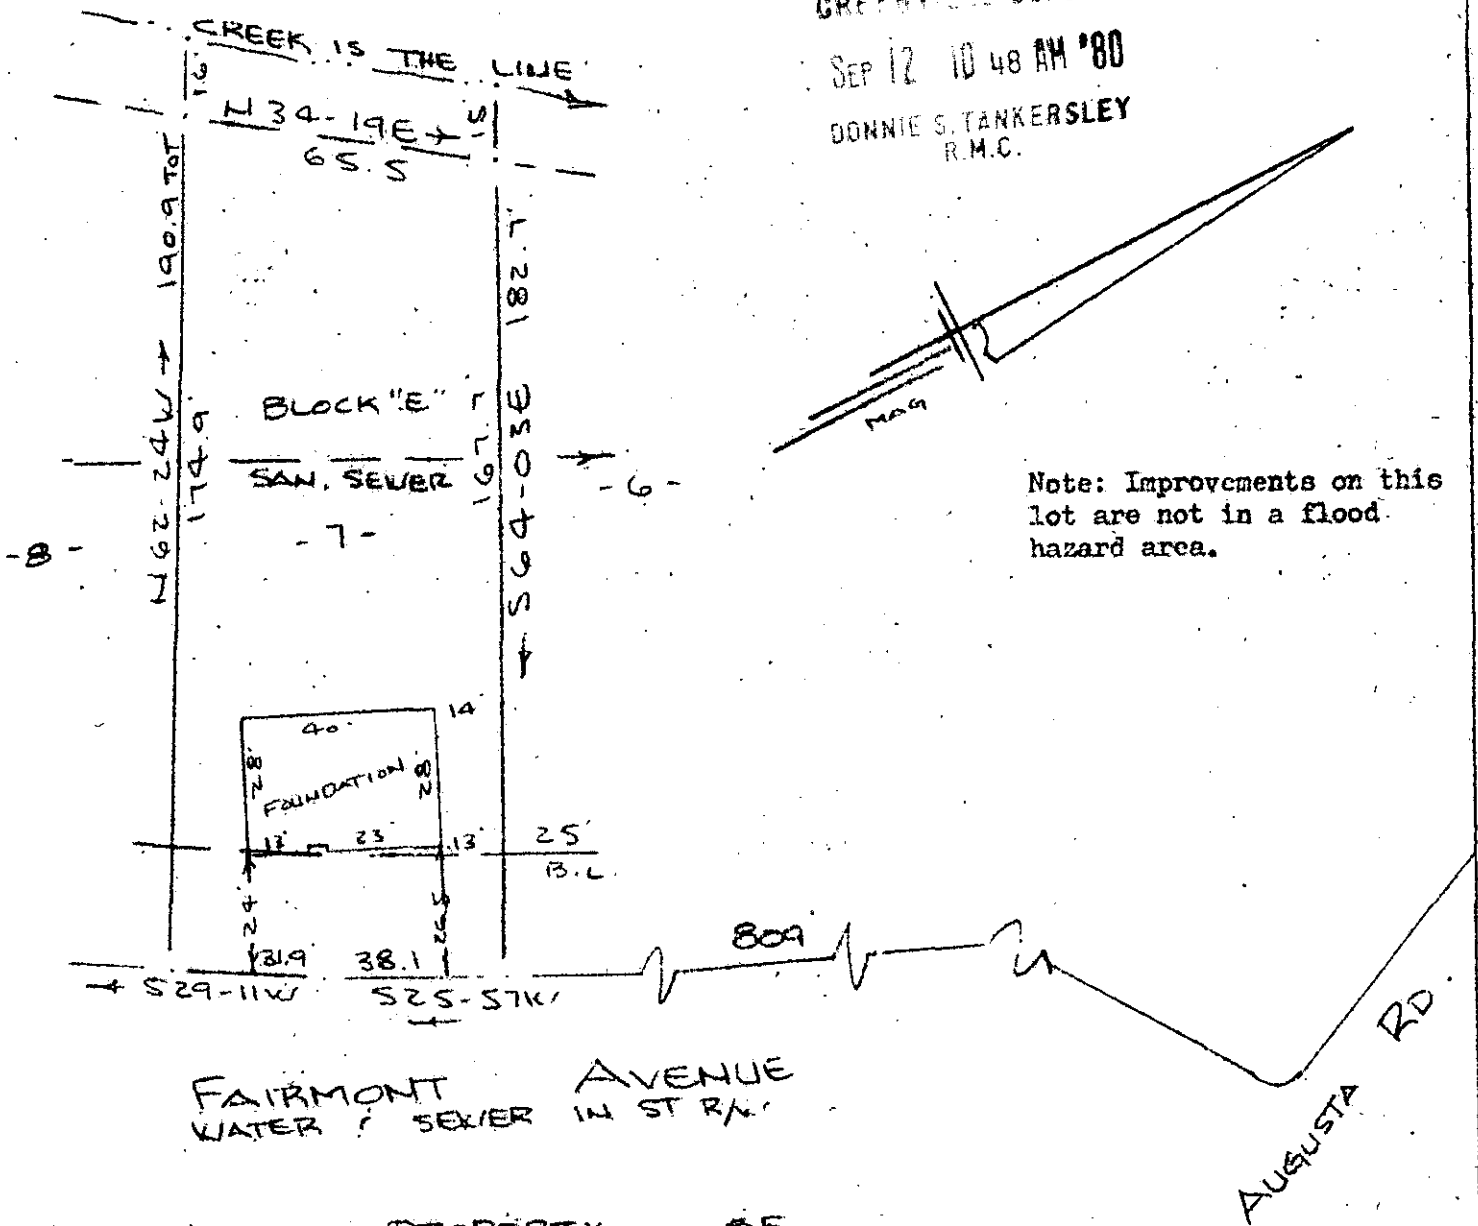

FAIRMONT AVENUE
WATER / SEWER IN ST. R/W

AUGUSTA RD.

PROPERTY OF
DEANE S. BAUMANN
NEAR GREENVILLE, S.C.
SCALE: 1" = 40' 18 JUNE 1980

This is to certify that on the 18th day of June, 1980, I surveyed the property shown on this plat, being known as lot 7 Block " E " on plat of BROOKFOREST and recorded in the RMC Office Greenville County, S. C., in Plat Book " BB " at Page 41; and that the property lines, walls and buildings are as shown hereon, and that the walls and buildings located on said lot do not encroach or project on adjacent street or on property, and that no adjacent walls or buildings encroach or project on said premises, and no power lines cross this property except as shown hereon.

✓ 8E-52

8066

REGISTERED

 R. B. BRUCE, SLS #1957
 R. BRUCE

CAROLINA SURVEYING CO.
112 Manly St., Greenville, S. C. 3.0001
GCTO 2 SE 12 80 1311