

MICROFILMED


FILED
GREENVILLE CO. S. C.
SEP 18 3 26 PM '80
DONNIE S. TANKERSLEY
R.M.C.

SEP 18 1980
8827 ✓

8-E-86 GAIL DRIVE

This is to certify that on September 17, 1980, I surveyed the property shown on this plat, known as Lot 37 on plat of Knollwood Heights Sec. 5, recorded in the RMC Office of Greenville County in Plat Book 4R on page 92, and that the property lines, walls and buildings are as shown hereon; that the building located on said lot does not encroach or project on adjacent streets or property, and that no adjacent walls or buildings encroach or project on said premises, and that no utility lines cross this property except as shown hereon. This property is not located in a designated flood hazard area.

5' drainage and utility easement each side of all side and rear lot lines. James R. Freeland
James R. Freeland RLS & PE 4781

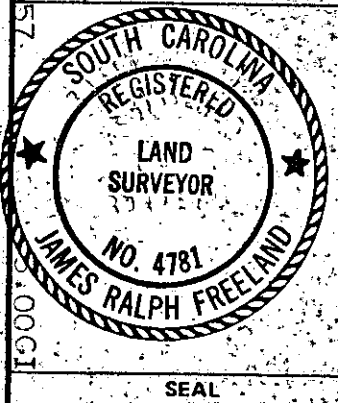

STATE OF SOUTH CAROLINA
GREENVILLE COUNTY
KNOLLWOOD HEIGHTS
SECTION 5 - LOT 37
PROPERTY OF
GEORGE O'SHIELDS
BUILDERS, INC.

FREELAND & ASSOCIATES
Engineers • Land Surveyors
GREENVILLE, S.C.
SURVEY MC
DRAWN J.R.F.
CHECK MC
SCALE 1" = 40'
DATE 9-17-80
DWG. NO. 80-5669