


MICROFILMED

FILED
GREENVILLE CO. S. C.
Dec 15 2 48 PM '80
DONNIE S. TANKERSLEY
R.M.C.

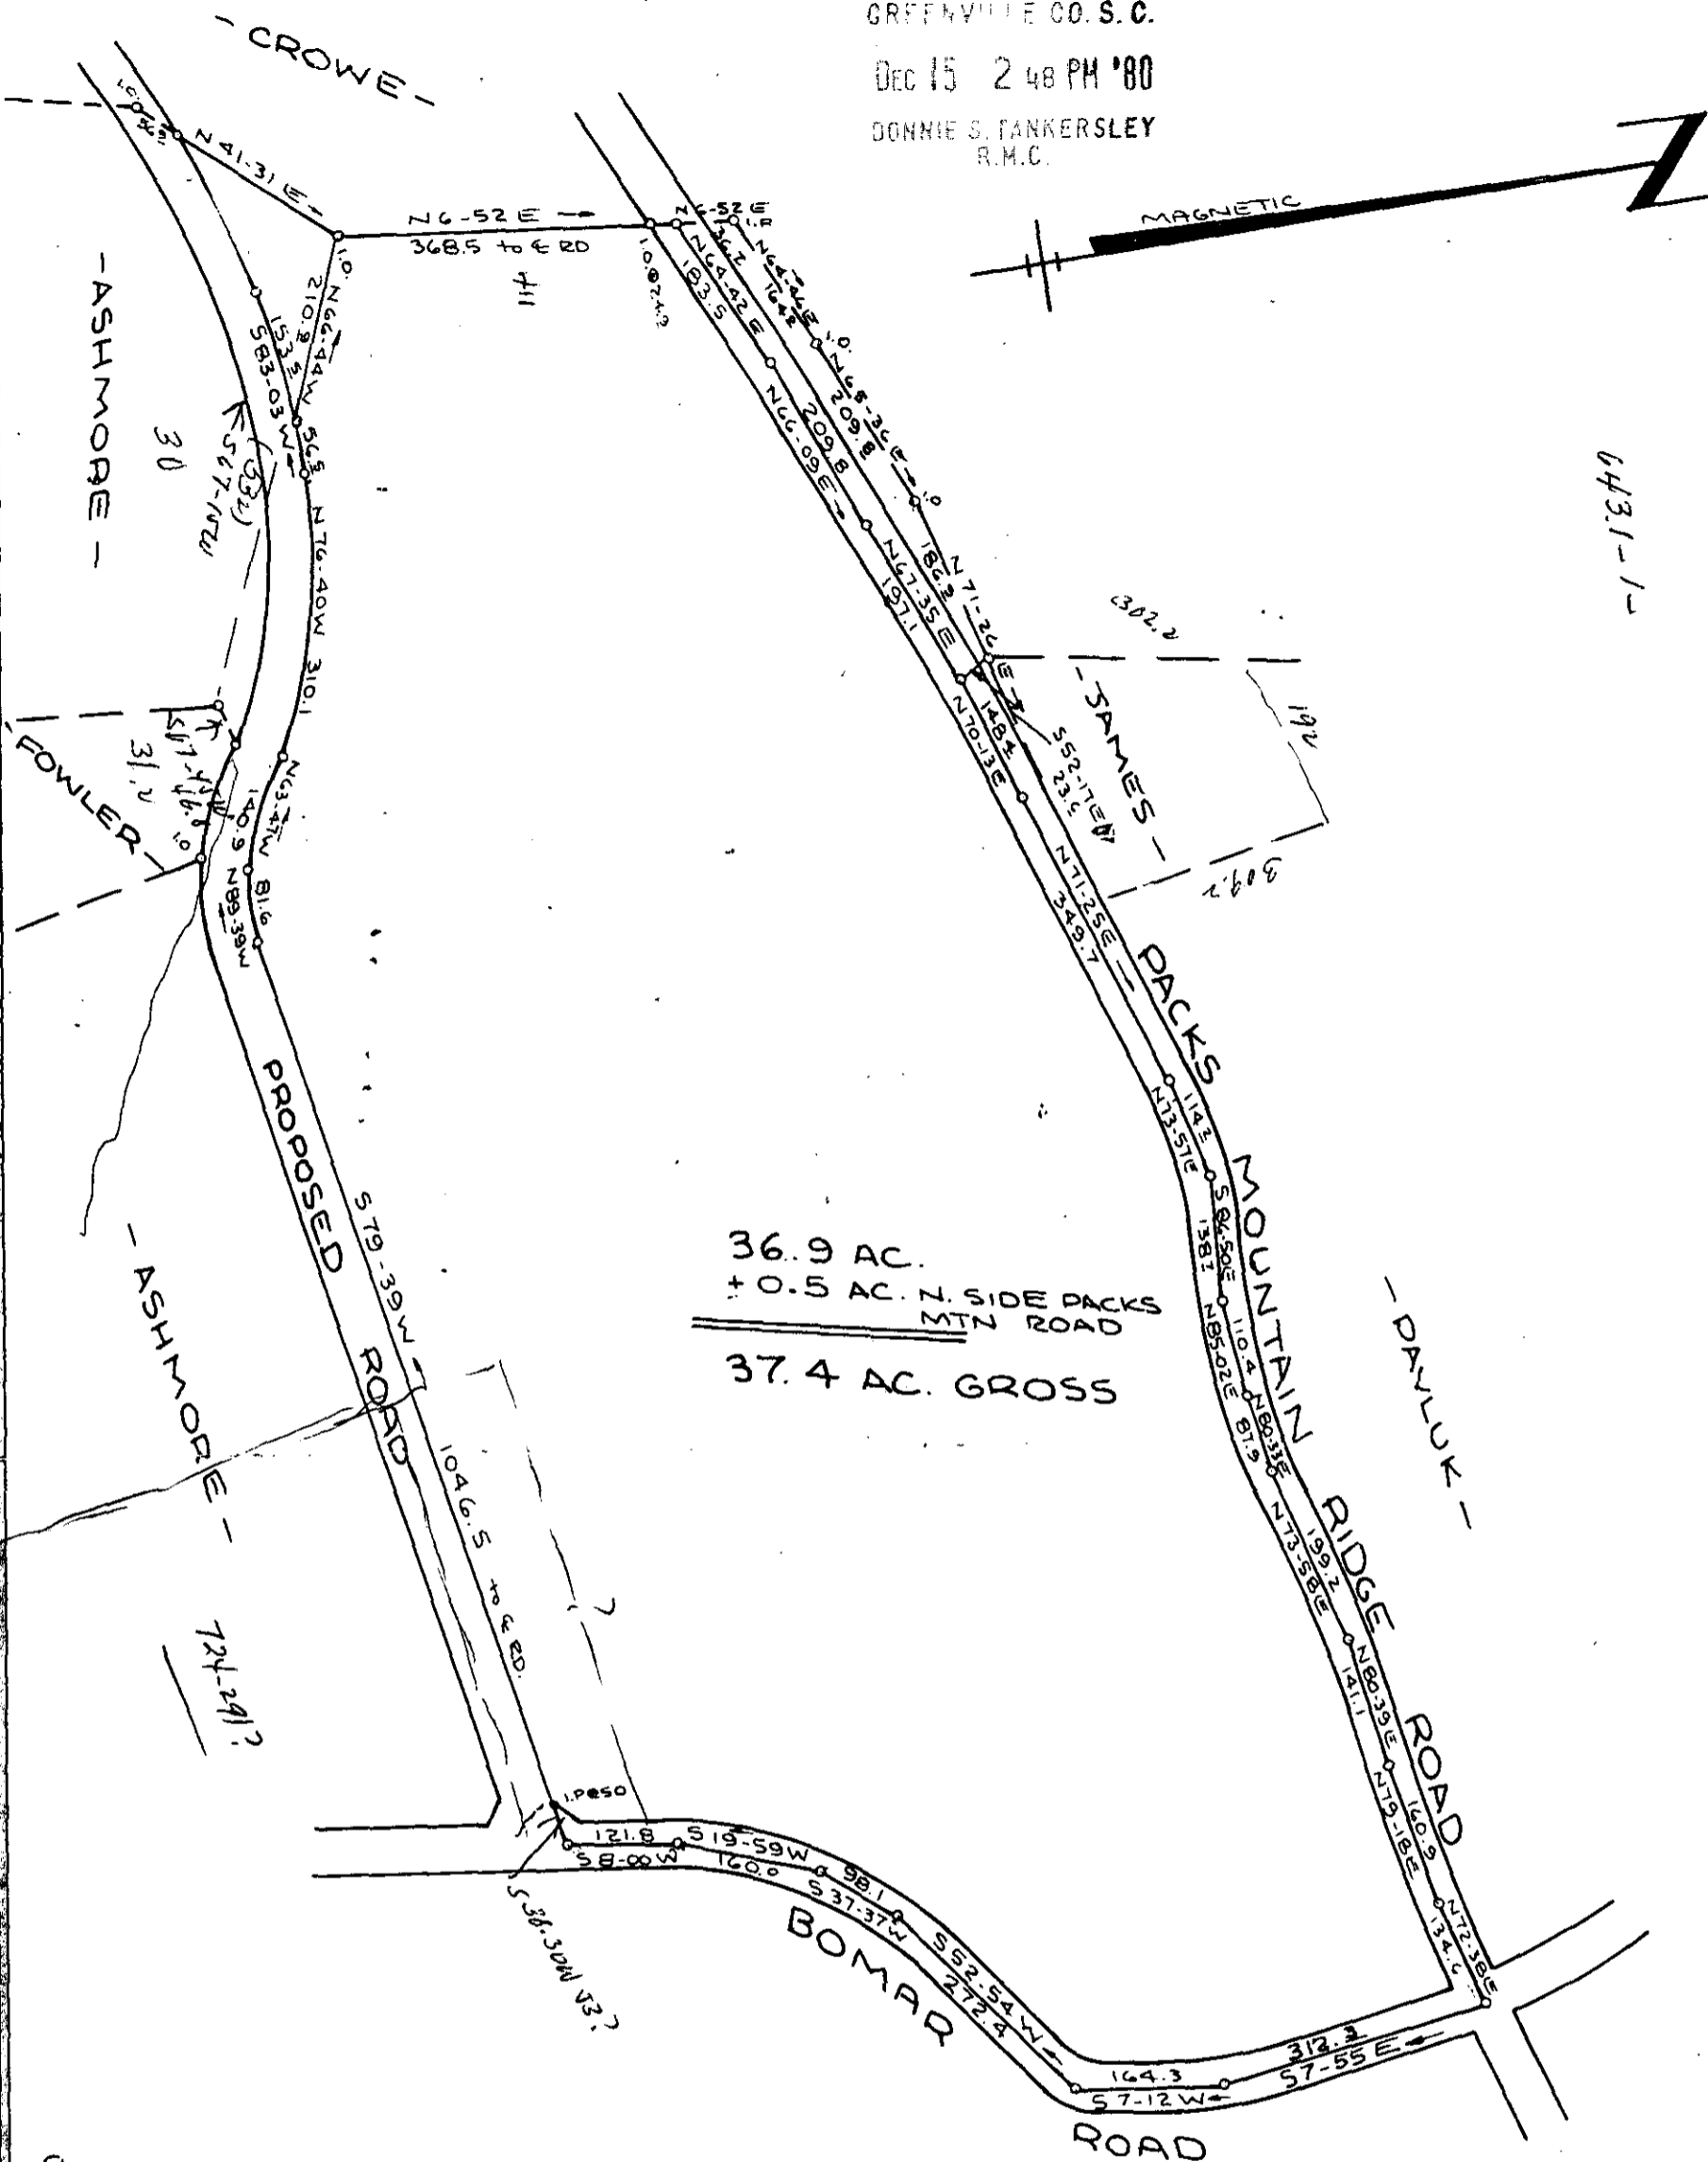

PROPERTY OF
JOHN P. ASHMORE, JR.
 PACKS MOUNTAIN GREENVILLE CO.
 SOUTH CAROLINA
 AUGUST 1980
 REVISED 9/3/80

17912 DEC 15 1980

✓ 8-7-90

SCALE: 1" = 200'



W. R. WILLIAMS, JR.
 ENGINEER/SURVEYOR
 P. E. & L. S. No. 3979
 15 S. MAIN STREET
 TRAVELERS REST, S. C.
 29690

"I hereby certify that the ratio of precision of the field survey is 1/2500 as shown hereon and the area was determined by D.M.D method of area calculation."

W.R. Williams, Jr. P. E. & L. S. No. 3979

GCTO ----- 3 DE15 80 138



6431-1-PT 33

258 C