


FILED
GREENVILLE CO. S.C.

OCT 16 11 37 AM '80

N/E
JONNIE S. TANKERSLEY
R.M.C.



This is to certify that on October 15, 1980, I surveyed the property shown on this plat, known as Lot 17 on plat of Knollwood Heights Section 4, recorded in the RMC Office of Greenville County in Plat Book 4N on page 74, and that the property lines, walls and buildings are as shown hereon; that the building located on said lot does not encroach or project on adjacent streets or property, and that no adjacent walls or buildings encroach or project on said premises, and that no utility lines cross this property except as shown hereon. This property is not located in a designated flood hazard area.

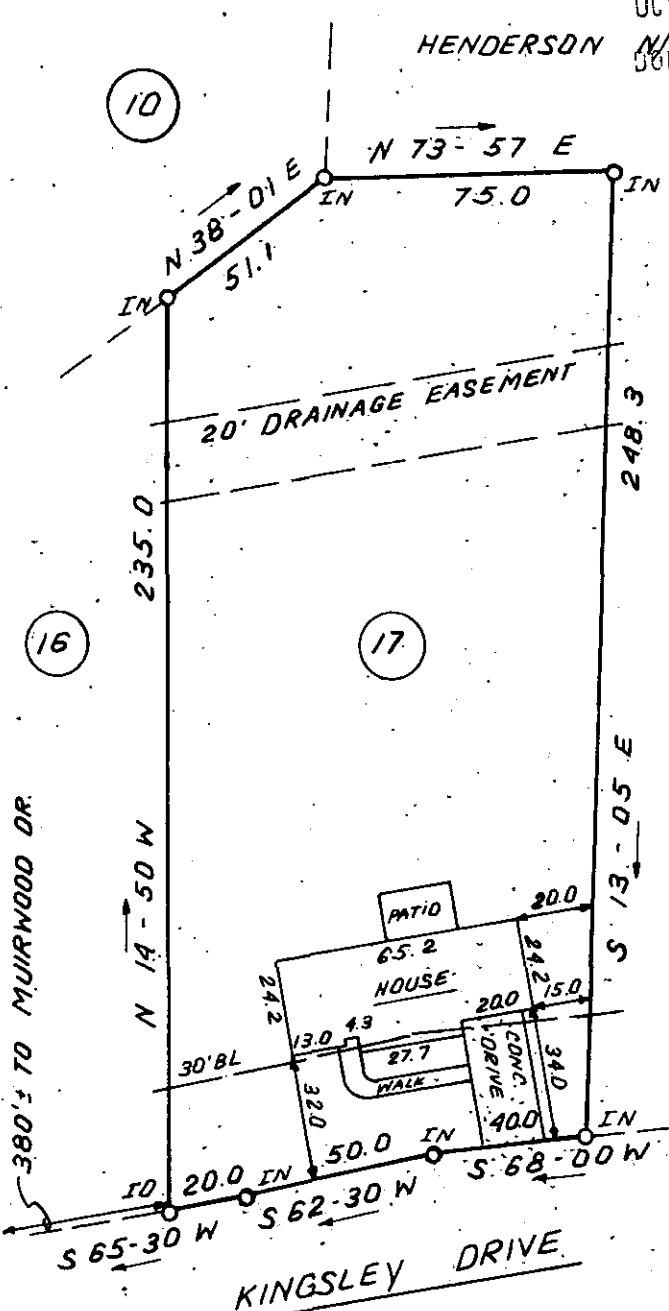

380' TO MUIRWOOD DR.

KINGSLEY DRIVE

TAX BLOCK BOOK M 8.1-1-117

James R. Freeland
James R. Freeland RLS & PE 4781

82-84 12009



STATE OF SOUTH CAROLINA
GREENVILLE COUNTY

KNOLLWOOD HEIGHTS
LOT 17, SEC. IV
PROPERTY OF
HARRY D. GEORGE
BEVERLY M. GEORGE

FREELAND & ASSOCIATES Engineers • Land Surveyors
GREENVILLE, S.C.
SURVEY <i>JRF</i>
DRAWN <i>B.R.</i>
CHECK <i>mc</i>
SCALE 1" = 50'
DATE <i>OCT. 15. 80</i>
DWG. NO. <i>5817</i>