

5' drainage and utility easement each side of all side and rear lot FILEDs.

GREENVILLE CO. S.C.

OCT 17 10 53 AM '80

BONNIE S. TANKERSLEY R.M.C.

This is to certify that on October 13, 1980, I surveyed the property shown on this plat, known as Lot 205 on plat of Westwood South Sec. 1, recorded in the RMC Office of Greenville County in Plat Book 6H on page 57, and that the property lines, walls and buildings are as shown hereon; that the building located on said lot does not encroach or project on adjacent streets or property, and that no adjacent walls or buildings encroach or project on said premises, and that no utility lines cross this property except as shown hereon. This property is not located in a designated flood hazard area.

206

205


204

8-6-88

OCT 17 1980

James R. Freeland RLS & PE 4781

12243

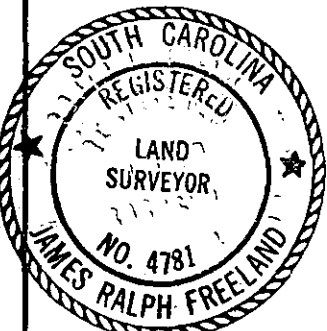

SEAL

STATE OF SOUTH CAROLINA
GREENVILLE COUNTY

WESTWOOD SOUTH
SEC. 1 - LOT 205
PROPERTY OF
JAMES R. SMITH
MARY JEAN SMITH

FREELAND & ASSOCIATES
Engineers • Land Surveyors

GREENVILLE, S.C.

SURVEY JC
DRAWN MC
CHECK MC
SCALE 1" = 40'
DATE 10-13-80
DWG. NO. 80-579B

