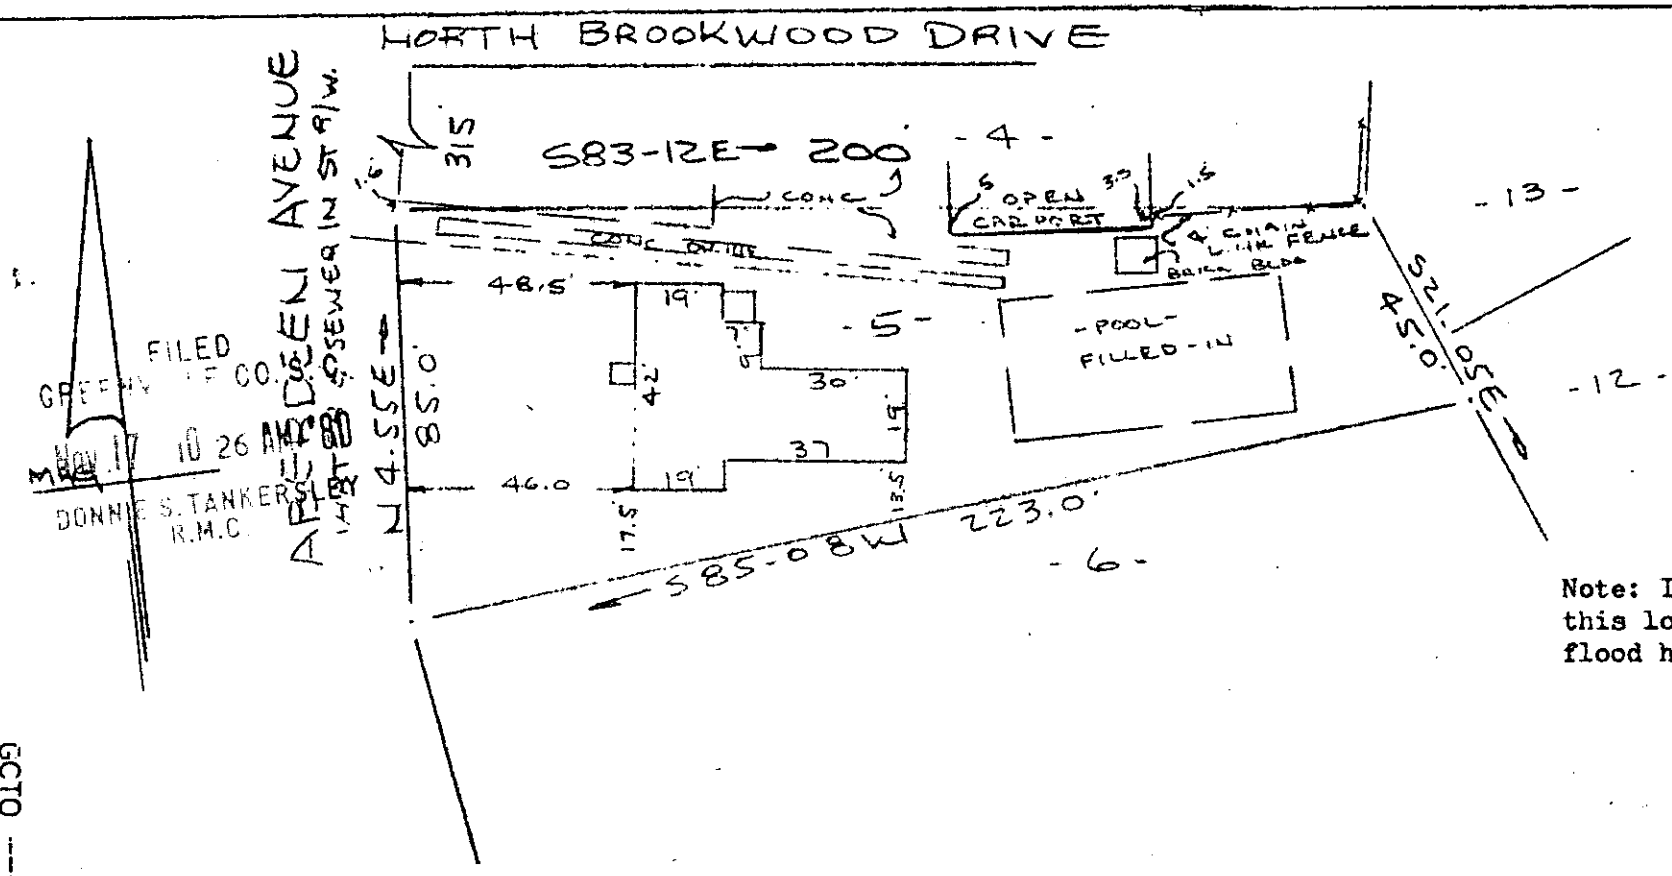

Note: Improvements on this lot are not in a flood hazard area.

PROPERTY OF
GEORGE E. LABBAN & CYNTHIA C. LABBAN
GREENVILLE, S. C.
SCALE 1" = 40' 12 NOV 1980

This is to certify that on the 12th day of November, 1980, I surveyed the property shown on this plat, being known as lot 5 on plat of PLAT NO. 2 PARK HILL and recorded in the RMC Office Greenville County, S. C., in Plat Book " H " at Page 79; and that the property lines, walls and buildings are as shown hereon, and that the walls and buildings located on said lot do not encroach or project on adjacent street or property, and that no adjacent walls or buildings encroach or project on said premises, and no power lines cross this property except as shown hereon.

8 H.77

15126

R. B. Bruce

R. B. Bruce, RLS #1952

CAROLINA SURVEYING CO.
112 Manly St.
Greenville, S. C.

GCTO ----- 3 NOV 17 80 1003

3.00CI

MICROFILMED

231/18

216-9-11