


DATE	SYM	REVISION RECORD	DR.	CR.

TANKERSLEY PROPERTY

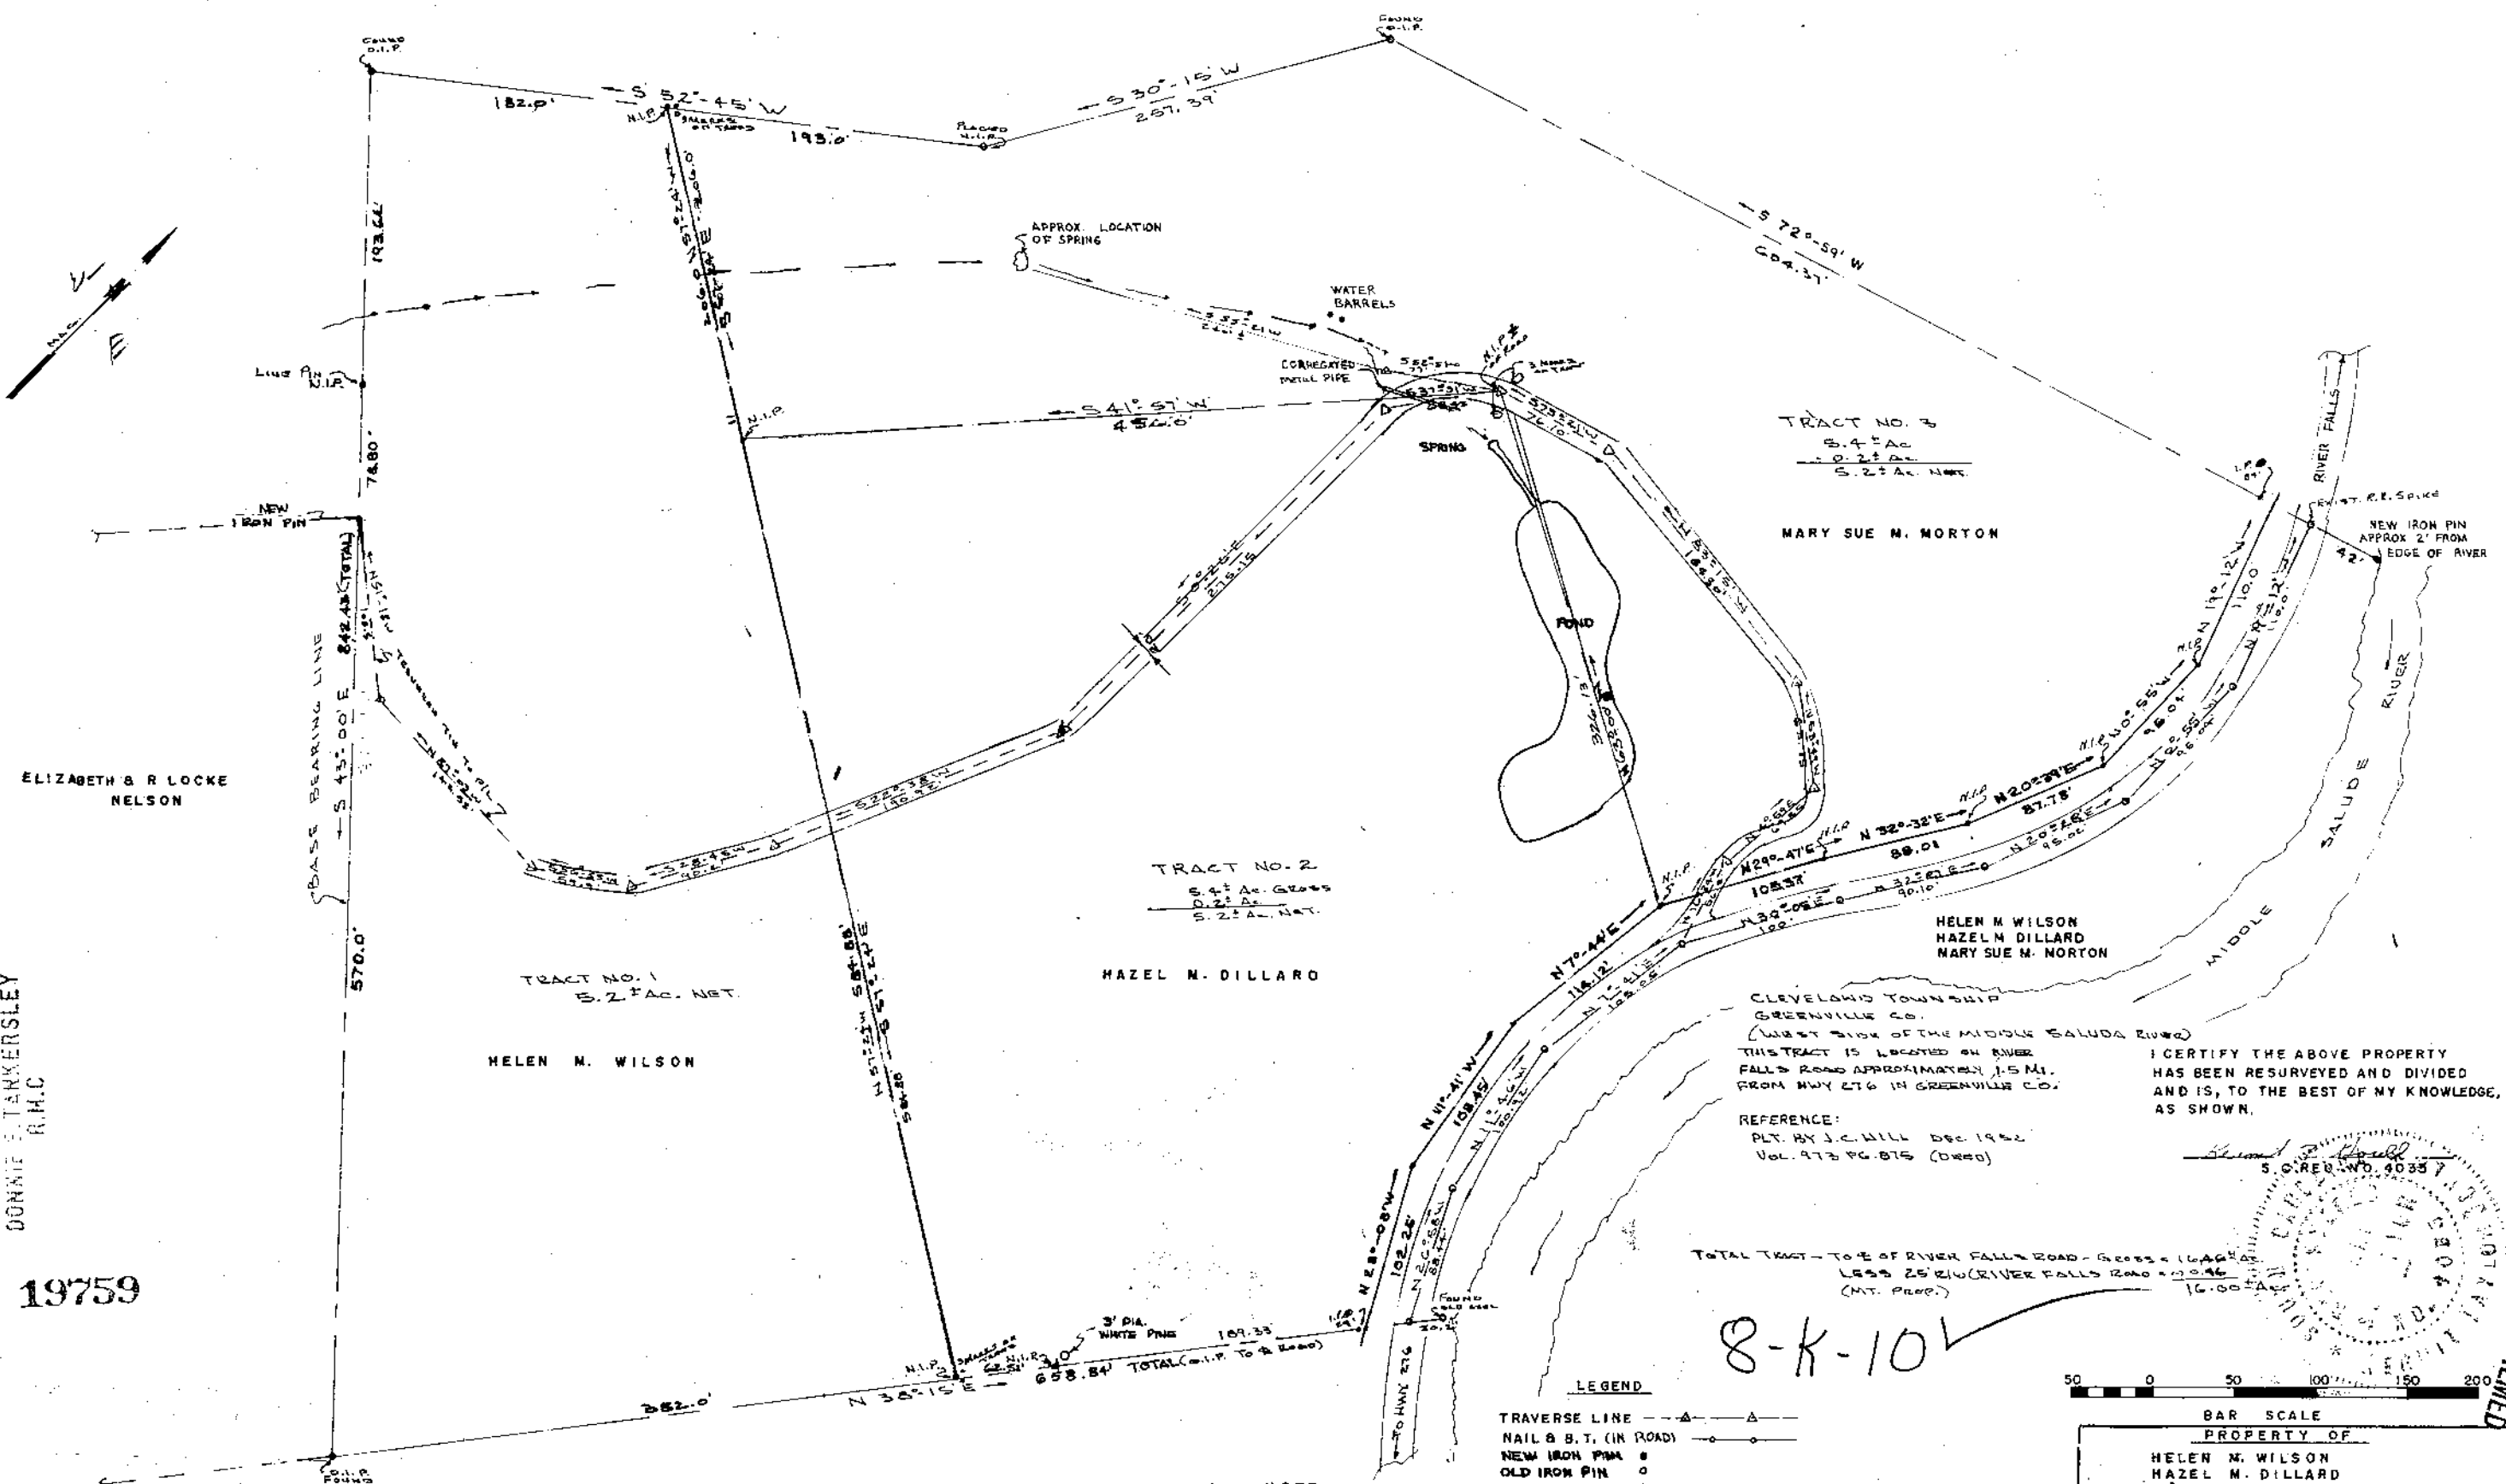

FILED
GREENVILLE CO. S.C.
JAN 7 11 47 AM '81
DONNIE E. TANKERSLEY
R.H.C.

19759

Handwritten signature
4338 JAN 7E


500 M

- NOTE
1. THE ROAD SHOWN IS A FEE SIMPLE ROAD (20' WIDE) WITH EACH PROPERTY OWNER HAVING AN UNDIVIDED INTEREST THEREIN. ACCESS ROAD IS NOT PUBLIC RIGHT OF WAY.
 2. ALL PROPERTY OWNERS TO HAVE USE OF WATER FROM SPRINGS.
 3. ALL PROPERTY OWNERS TO HAVE USE OF POND.

8-K-101

FOR RECORDING.

I CERTIFY THE ABOVE PROPERTY HAS BEEN RESURVEYED AND DIVIDED AND IS, TO THE BEST OF MY KNOWLEDGE, AS SHOWN.

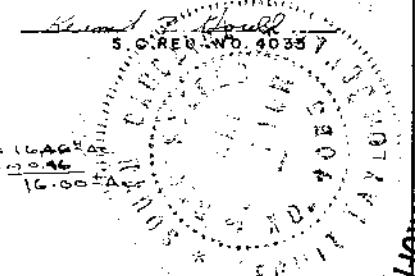

BAR SCALE	
50	0 50 100 150 200
PROPERTY OF	
HELEN M. WILSON HAZEL M. DILLARD MARY SUE M. NORTON	
SCALE 1" = 50'	DRAWN BY K.T.G.
APPROVED BY	
GOULD & ASSOC. SURVEYORS	
DATE 12-3-60	DRAWING NUMBER S.C.

MICROFILMED