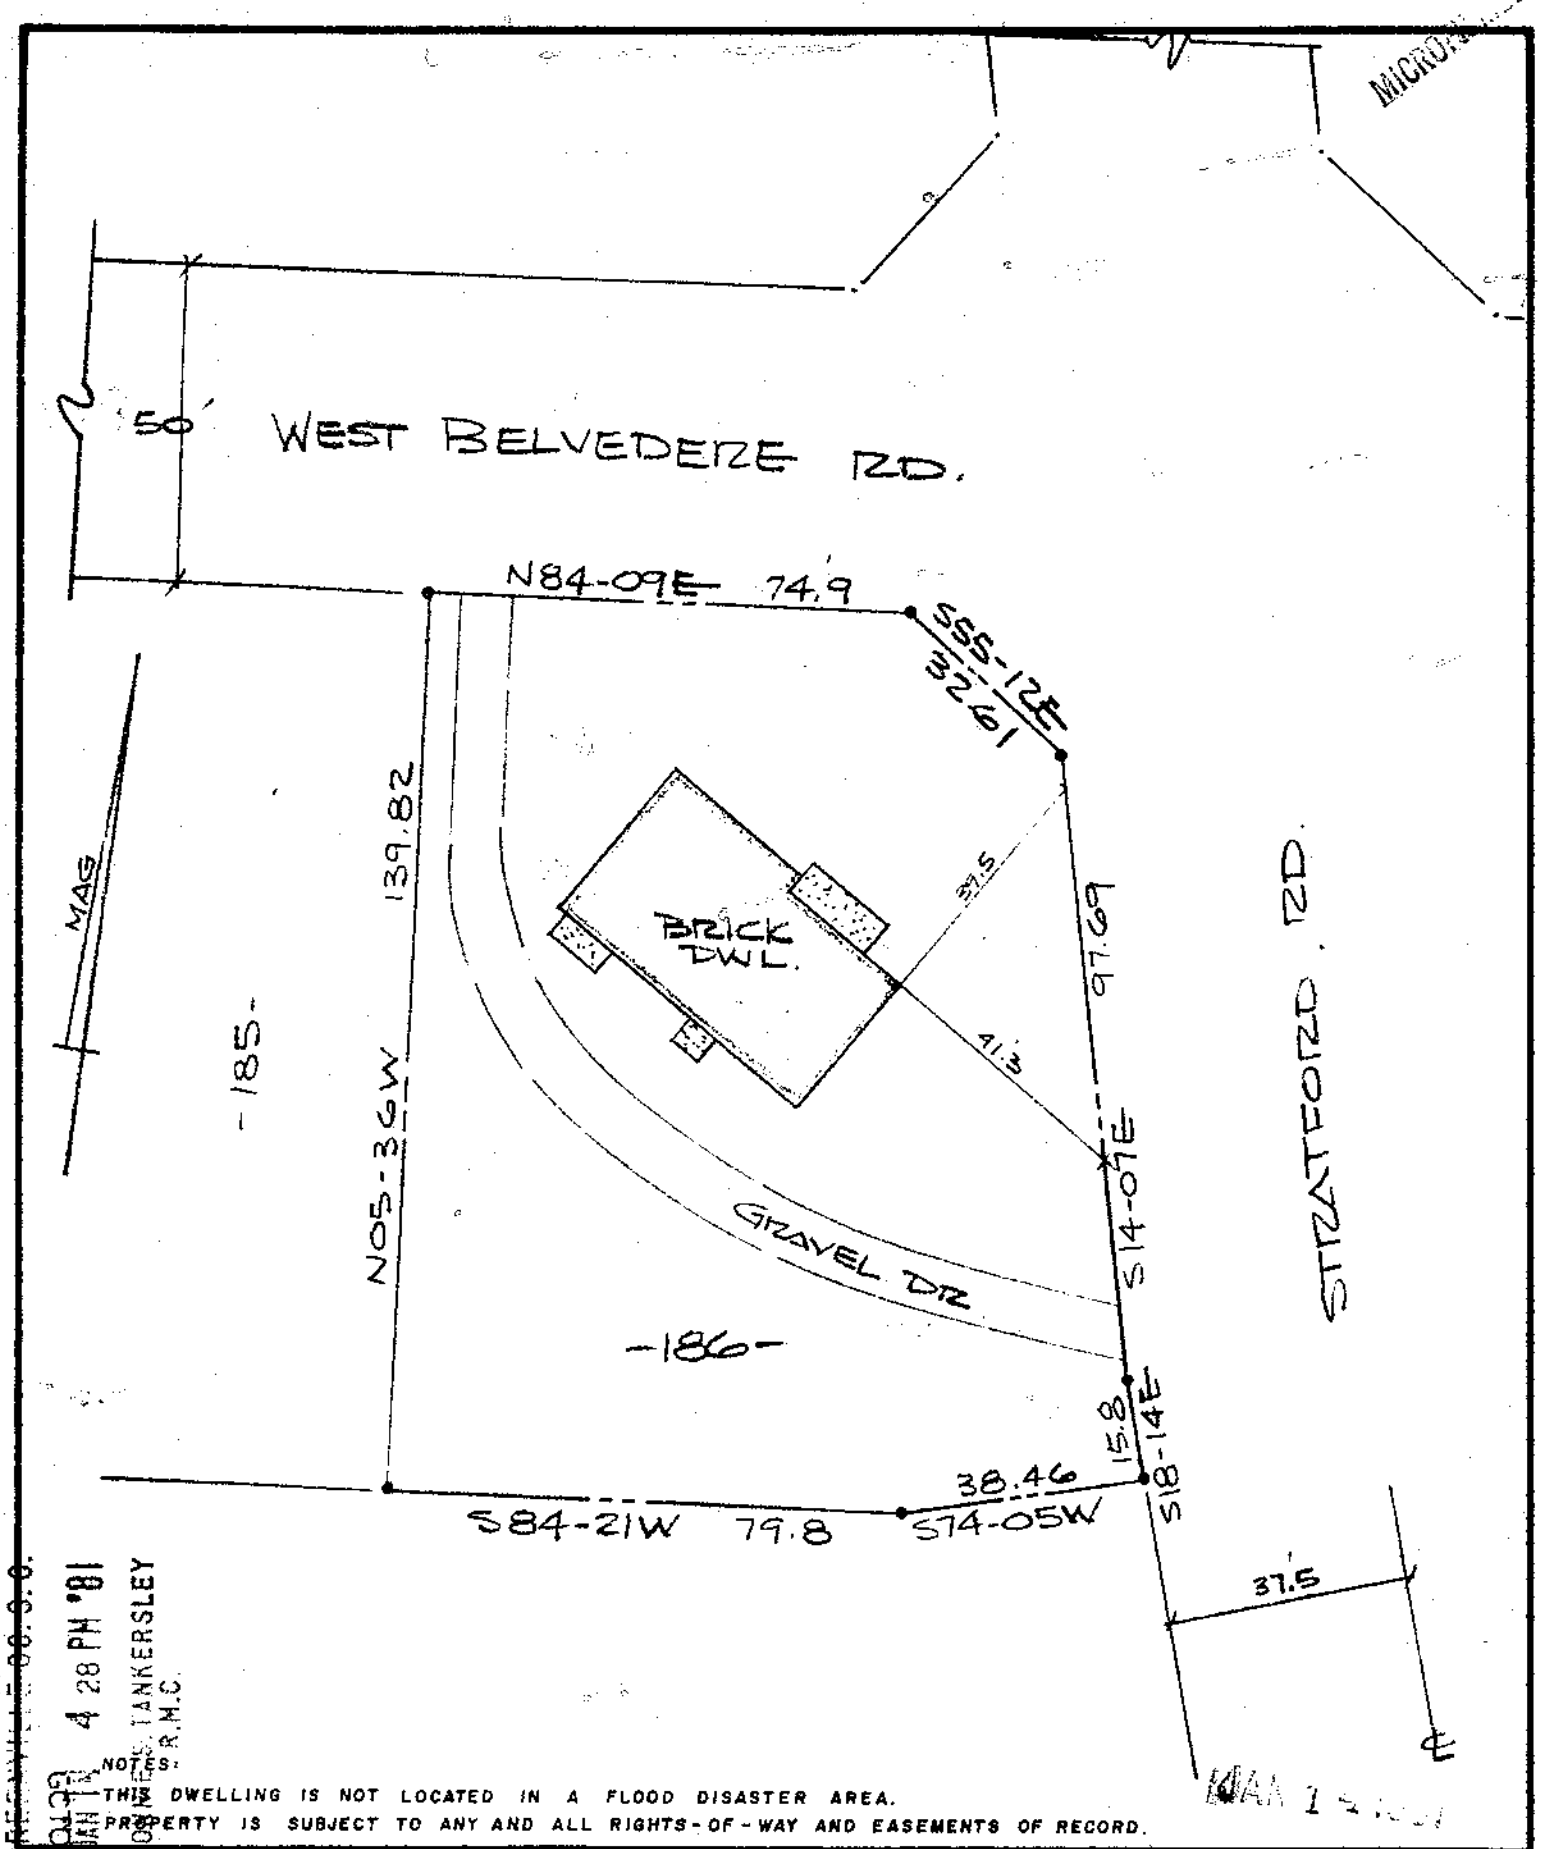

NOTES:
THIS DWELLING IS NOT LOCATED IN A FLOOD DISASTER AREA.
PROPERTY IS SUBJECT TO ANY AND ALL RIGHTS-OF-WAY AND EASEMENTS OF RECORD.

THIS IS TO CERTIFY THAT ON THE DATE SHOWN HEREON, I DID SURVEY THE ABOVE PROPERTY. THE SAME BEING KNOWN AND DESIGNATED AS LOT No. 186 OF SOUTH FOREST ESTATES. AS SHOWN BY A PLAT RECORDED IN THE CLERK OF COURTS OFFICE FOR GREENVILLE COUNTY IN PLAT BOOK GG AT PAGE 181. I FURTHER CERTIFY THAT THE PROPERTY LINES, STREETS, AND BUILDINGS ARE AS SHOWN ABOVE AND THAT THERE ARE NO ENCROACHMENTS EXCEPT AS SHOWN.

JAN 5, 1981
DATE

20347
8-K-17

ROBERT R. SPEARMAN REG. L.S. NO. 3615

TITLE	LEGEND	SEAL
SURVEY FOR CHARLES W. LATIMORE & LINDA LATIMORE	● IRON PIN (OLD) ⊕ IRON PIN (NEW) △ NAIL & CAP ⊡ AS NOTED	SOUTH CAROLINA REGISTERED NO. 3615 ROBERT R. SPEARMAN
STATE: SOUTH CAROLINA / COUNTY: GREENVILLE	GRAPHIC SCALE 15 0 30	
SCALE: 1"=30 / DATE: 1/5/81 / REF. NO.	ROBERT R. SPEARMAN Registered Surveyor 3615 Post Office Box 8 Easley, South Carolina 29640 PH. 803-859-2309	

N78951

FILED
4 28 PM '81
JAN 13
GREENVILLE CO. S.C.
3 JA14 81 1080