


SURVEY FOR
 CHARLES L. BREWER
 MARJORIE S. BREWER
 NORTH OF TRAVELERS REST GREENVILLE CO.

SOUTH CAROLINA
 JUNE 1978
 REVISED-FOUNDATION SURVEY - JAN 30, 1981

FEB 1 0 1981

8-K-29

SCALE 1" = 100'

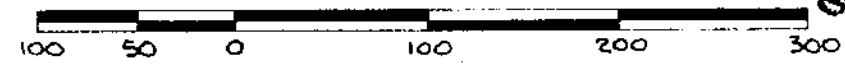

To The Best Of My Knowledge This Structure Is Not In An Established Flood Zone.

I Hereby Certify That The Measurements As Shown Above Are Correct And There Are No Encroachments Or Projections Other Than Shown.

W.R. Williams, Jr. P.E./L.S. #3979
 15 S. MAIN ST.
 TRAVELERS REST, S.C.

F.B. 27

505.8-1-PT. 7.3