


JAMES

This is to certify that on the 16th day of January, 1981, I surveyed the property shown on this plat, being known as lot 38 on plat of HIGHLAND SUBDIVISION and recorded in the RMC Office Greenville County, S. C., in Plat Book "C" at Page 146; and that the property lines, walls and buildings are as shown hereon, and recorded in the RMC Office Greenville County, S. C., in Plat Book " C " at Page that the walls and buildings located on said lot do not encroach or project on adjacent street or property, and that no adjacent walls or buildings encroach or project on said premises, and no power lines cross this property except as shown hereon.

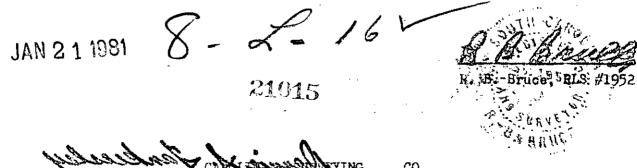

Manly

Greenville,

GCTO